


T. 1 N., R. 4 W., W.M.

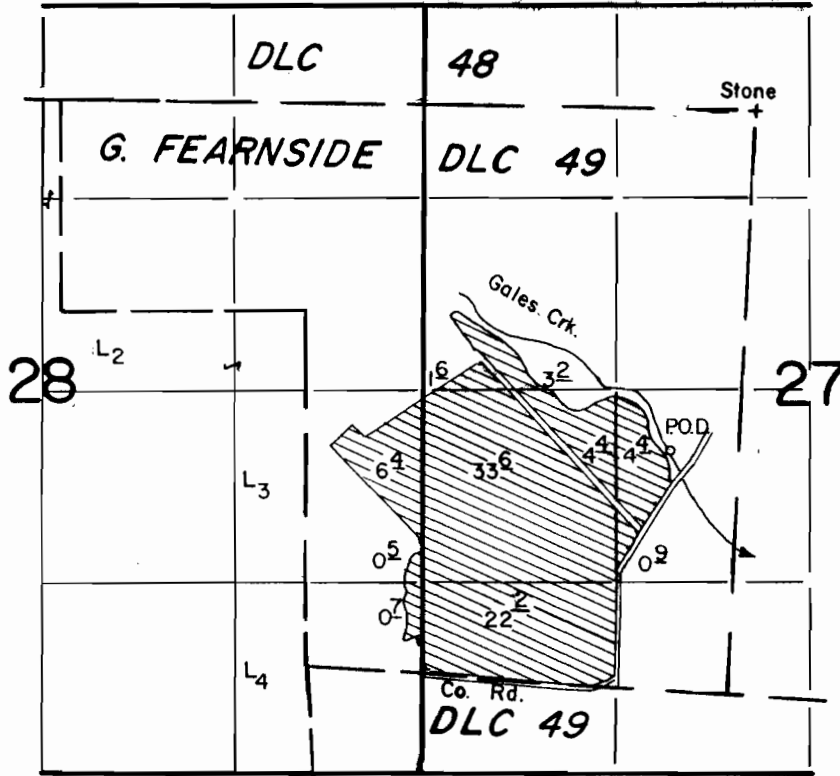

P.O.D. Loc. : 2300' S. & 600' W. from NE. Cor. DLC 49.

Scale : 1" = 1320'

FINAL PROOF SURVEY

UNDER

TRANSFER 5627

Application No. Permit No.

IN NAME OF

S. & S. FARMS

Surveyed JUNE 25 1987, by Ben Bishop