


T. 24S., R. 32 1/2 E., W.M.

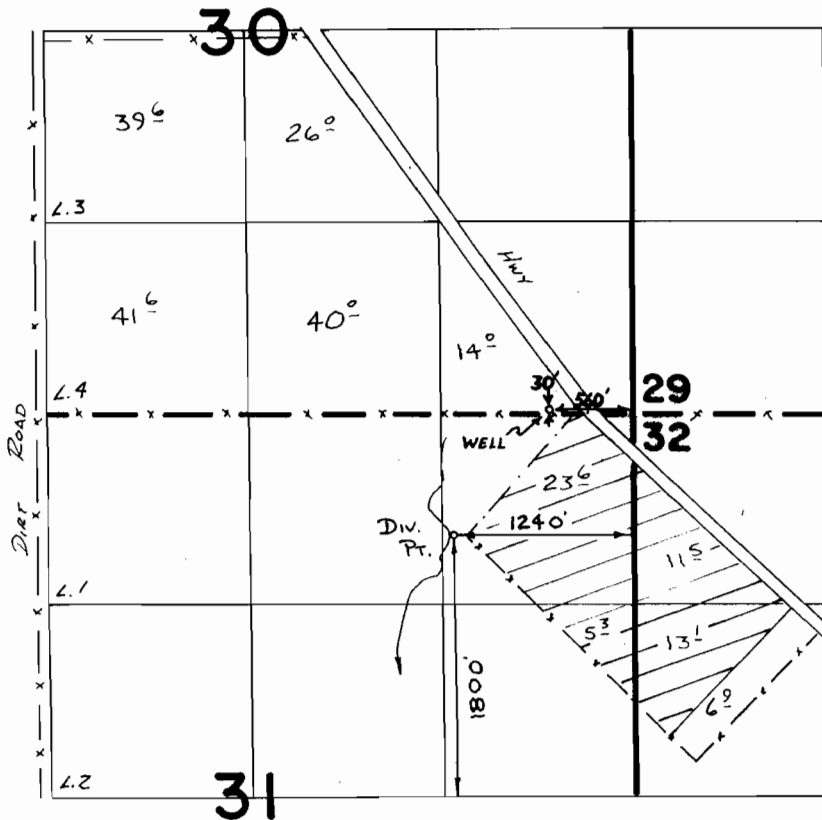

SCALE 1" = 1320'

FINAL PROOF SURVEY
UNDER

G-11378 G10512
Application No. **68368** Permit No. **49406**
IN NAME OF

.....**JAMES W. MASON, JR.**.....

Surveyed ...5-9... 1988, by *V.H. Church*.....