

T. 26 S., R. 30 E., W. M.


FINAL PROOF SURVEY

UNDER

Application G-10268 Permit G-9419

IN THE NAME OF

Surveyed 8-9-2001 & 9-18-2001 by J. Miller

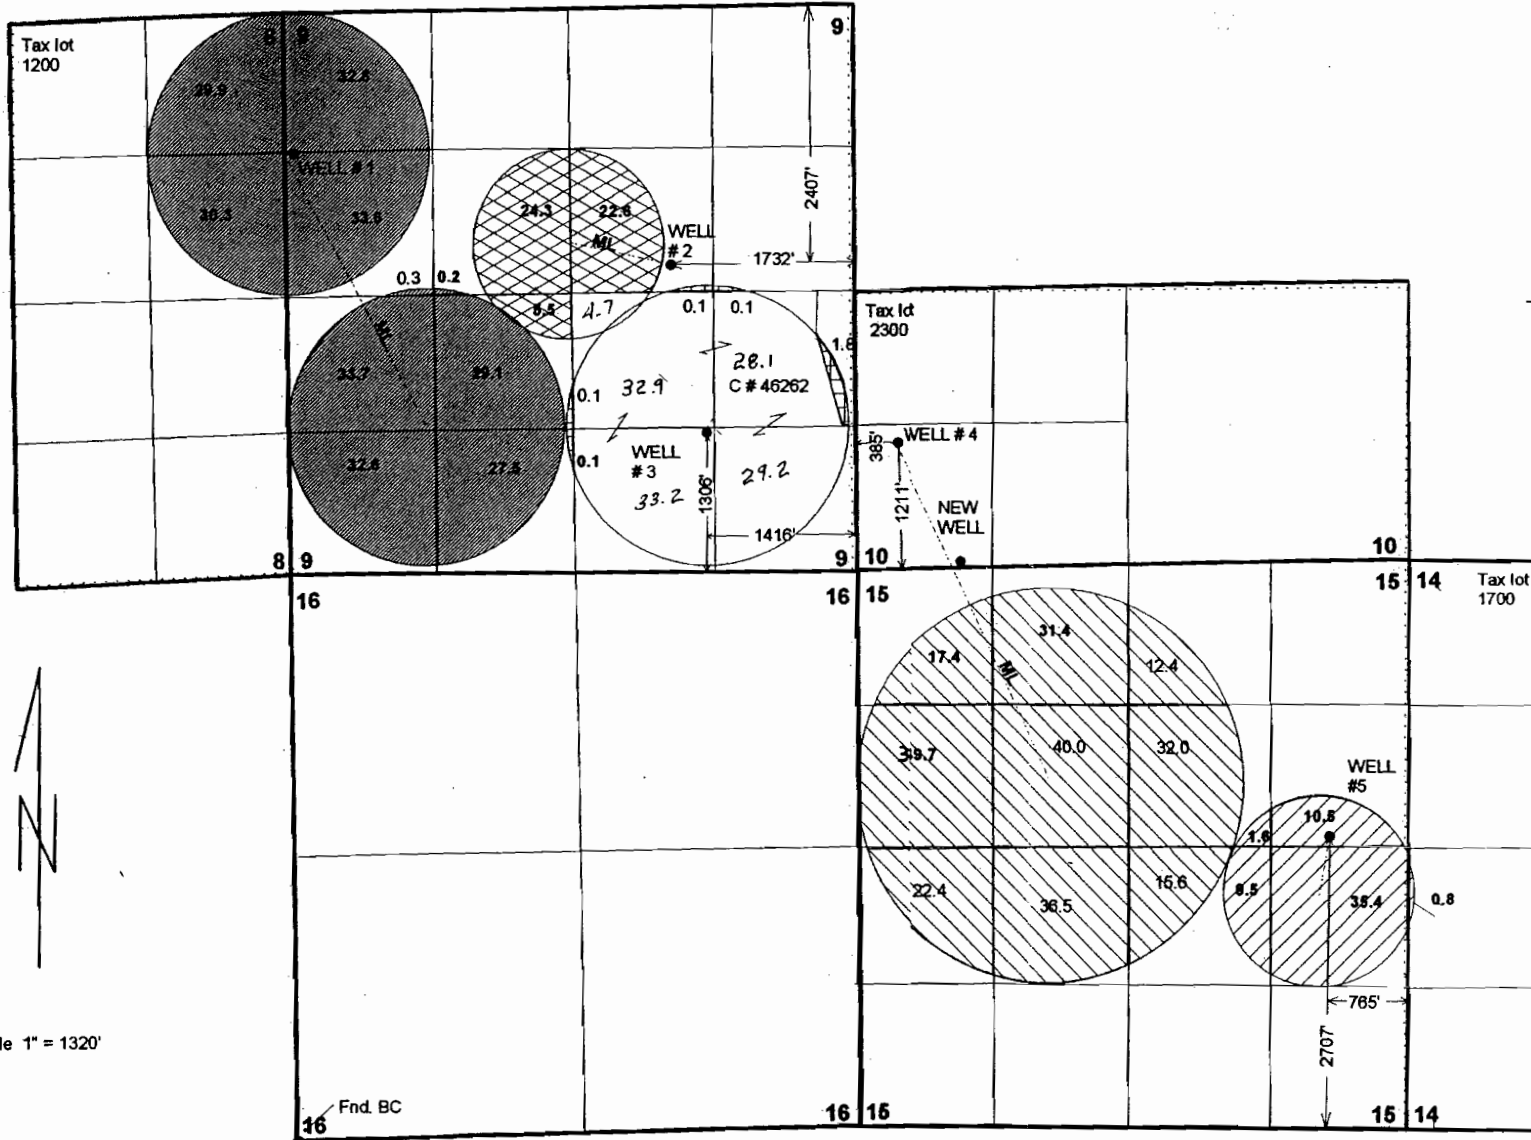

Scale 1" = 1320'

	Irr well # 1		Irr well # 4
	Irr well # 2		Irr well # 5
	Irr well # 3		

Well # 1 - 1330' S. & 65' E. from the Northwest Corner of Section 9