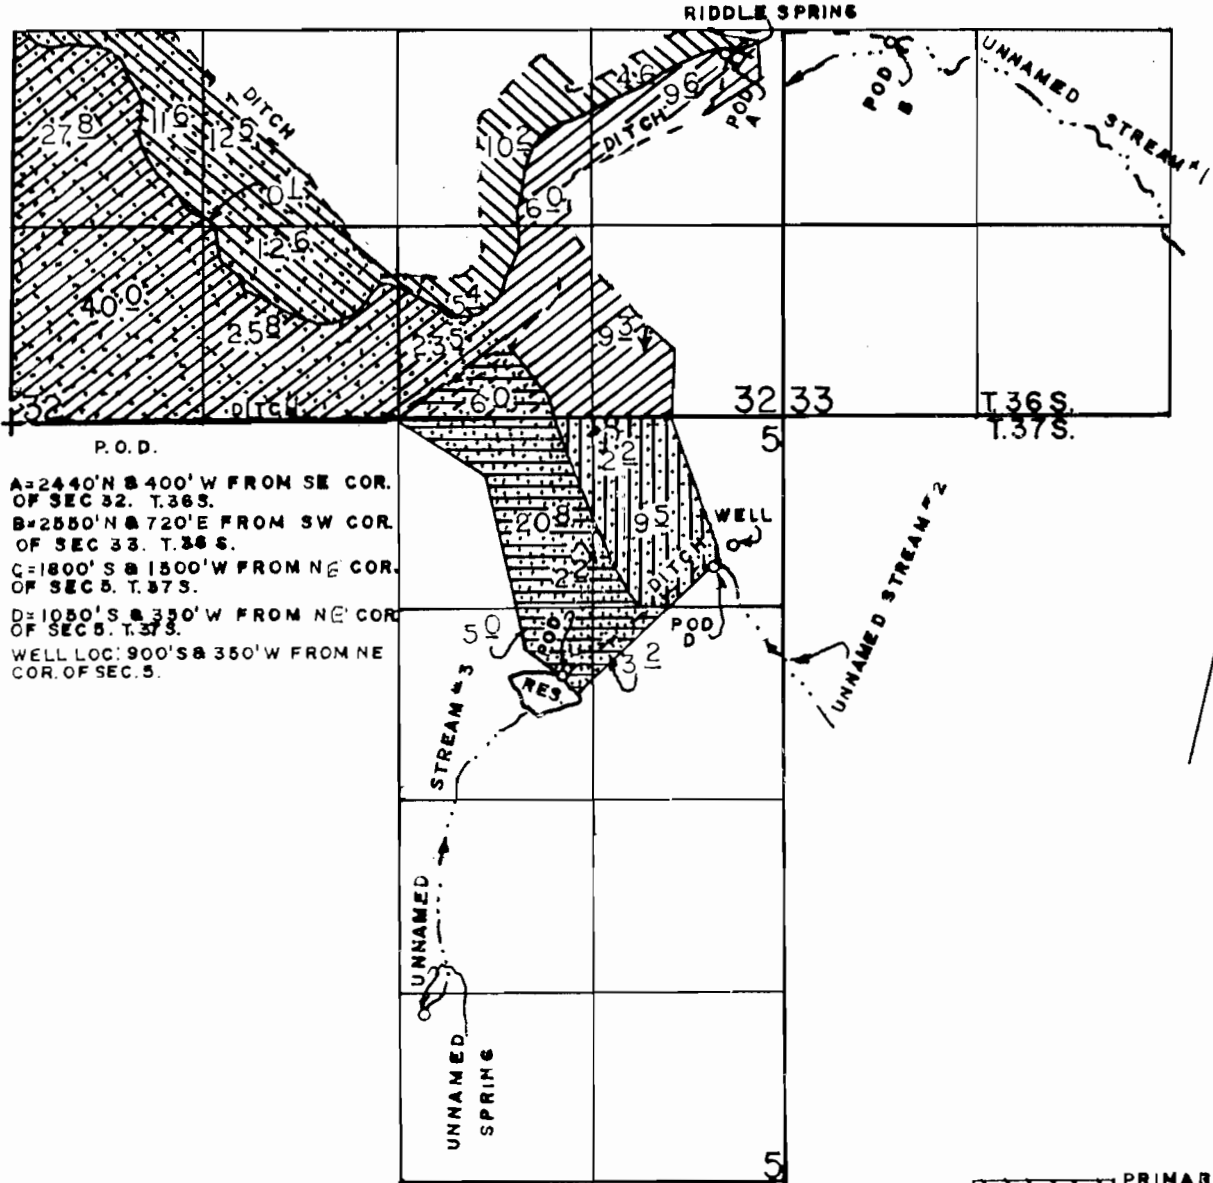


T. 36S.
T. 37S., R. 12E., W.M.



P.O.D.
 A=2440' N & 400' W FROM SE COR.
 OF SEC 32, T.36S.
 B=2550' N & 720' E FROM SW COR.
 OF SEC 33, T.36 S.
 C=1800' S & 1500' W FROM NE COR.
 OF SEC 5, T.37S.
 D=1050' S & 350' W FROM NE COR.
 OF SEC 5, T.37S.
 WELL LOC: 900' S & 350' W FROM NE
 COR. OF SEC. 5.





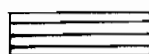

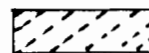
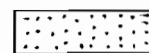
SCALE: 1" = 1320'

FINAL PROOF SURVEY

UNDER
 G-11133 R-50242 Application No. 49987 Permit No. 39383
 G-10260 R-6307
 IN NAME OF

GEORGE & RUTH DOUGAN

Surveyed JUNE 8, 1994, by R.M.SUTTERFIELD

-  PRIMARY STREAM 1.
SUPPLEMENTAL FROM RIDDLE SPR.
-  PRIMARY RIDDLE
-  SUPPLEMENTAL RES
PRIMARY STR. 3
-  PRIMARY STR. 2
-  SUPPLEMENTAL RIDDLE
-  SUPPLEMENTAL WELL