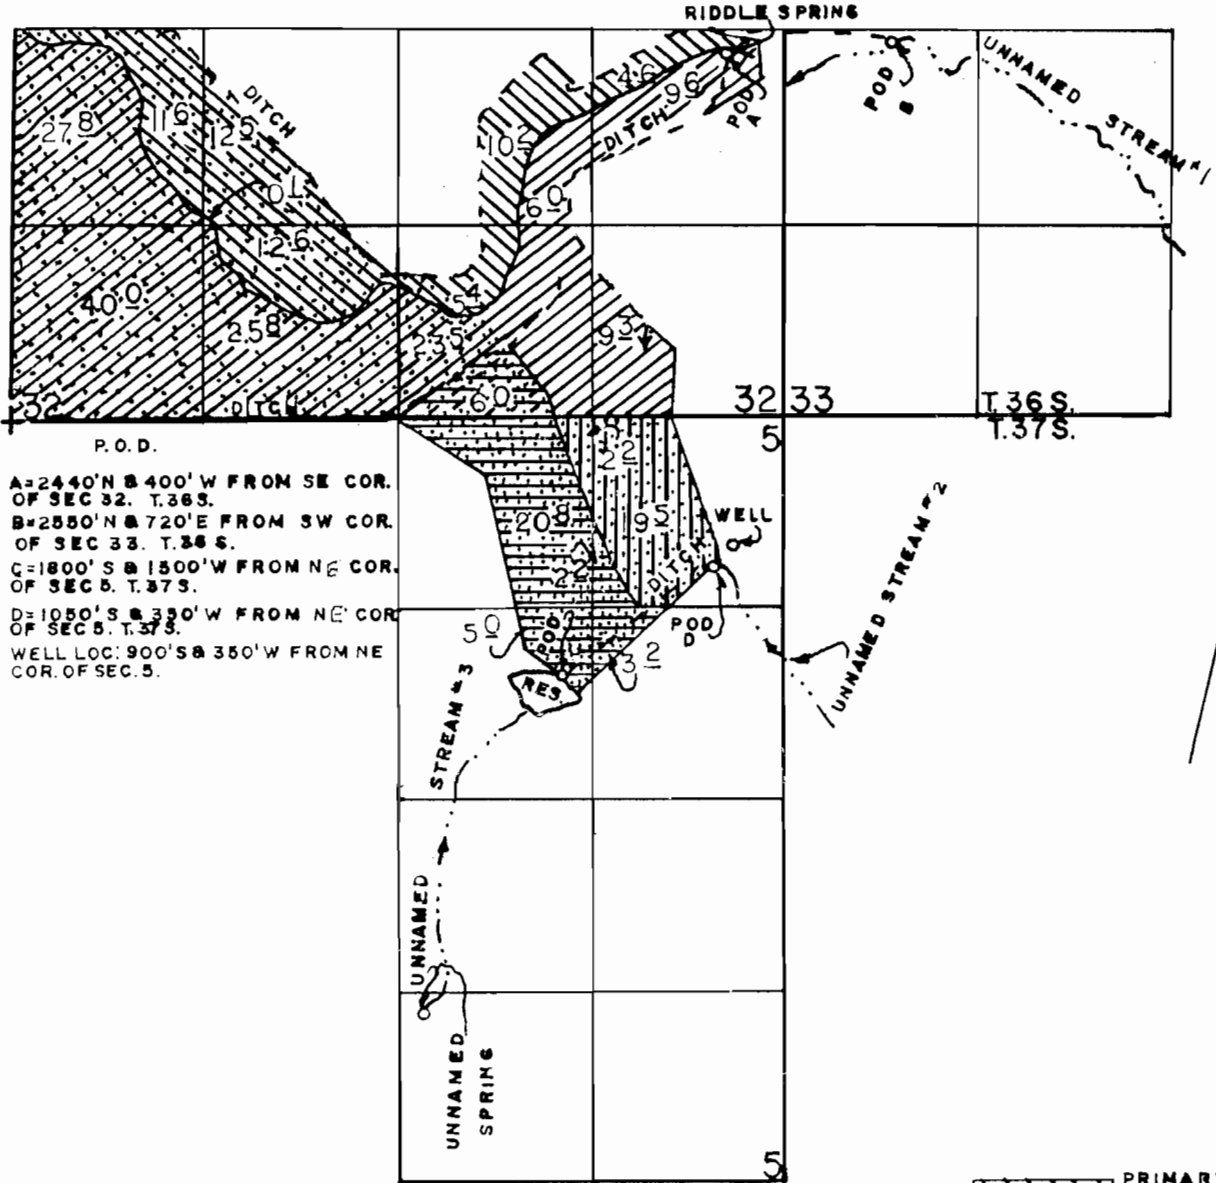


T. 36S.  
T. 37S., R. 12E., W.M.



P.O.D.  
 A=2440'N & 400'W FROM SE COR. OF SEC 32, T.36S.  
 B=2550'N & 720'E FROM SW COR. OF SEC 33, T.36S.  
 C=1800'S & 1500'W FROM NE COR. OF SEC 5, T.37S.  
 D=1050'S & 350'W FROM NE COR. OF SEC 5, T.37S.  
 WELL LOC: 900'S & 350'W FROM NE COR. OF SEC. 5.





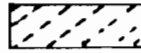
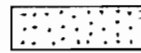
SCALE: 1" = 1320'

FINAL PROOF SURVEY

UNDER  
 G-11133 R-50242 Application No. 49987 Permit No. 39383  
 G-10260 R-6307  
 IN NAME OF

GEORGE & RUTH DOUGAN

Surveyed JUNE 8, 1994, by R.M.SUTTERFIELD

-  PRIMARY STREAM I. SUPPLEMENTAL FROM RIDDLE SPR.
-  PRIMARY RIDDLE
-  SUPPLEMENTAL RES PRIMARY STR. 3
-  PRIMARY STR. 2
-  SUPPLEMENTAL RIDDLE
-  SUPPLEMENTAL WELL