


# T. 30 S., R. 9 E., W.M.

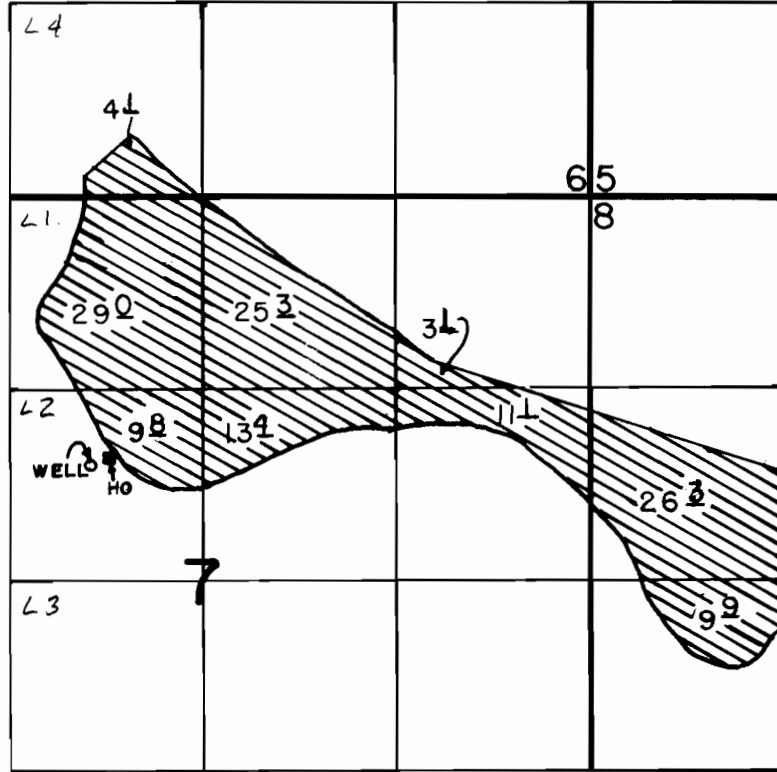

WELL LOC: 1840'S. & 3420'W. FROM NE COR. OF SEC 7.

SCALE: 1" = 1320'

## FINAL PROOF SURVEY

UNDER

Application No. G-10585 Permit No. G-9706  
IN NAME OF

KENNETH EMERY

Surveyed JULY 20., 1992, by B.W.BISHOP

11/6/06

L.M.V