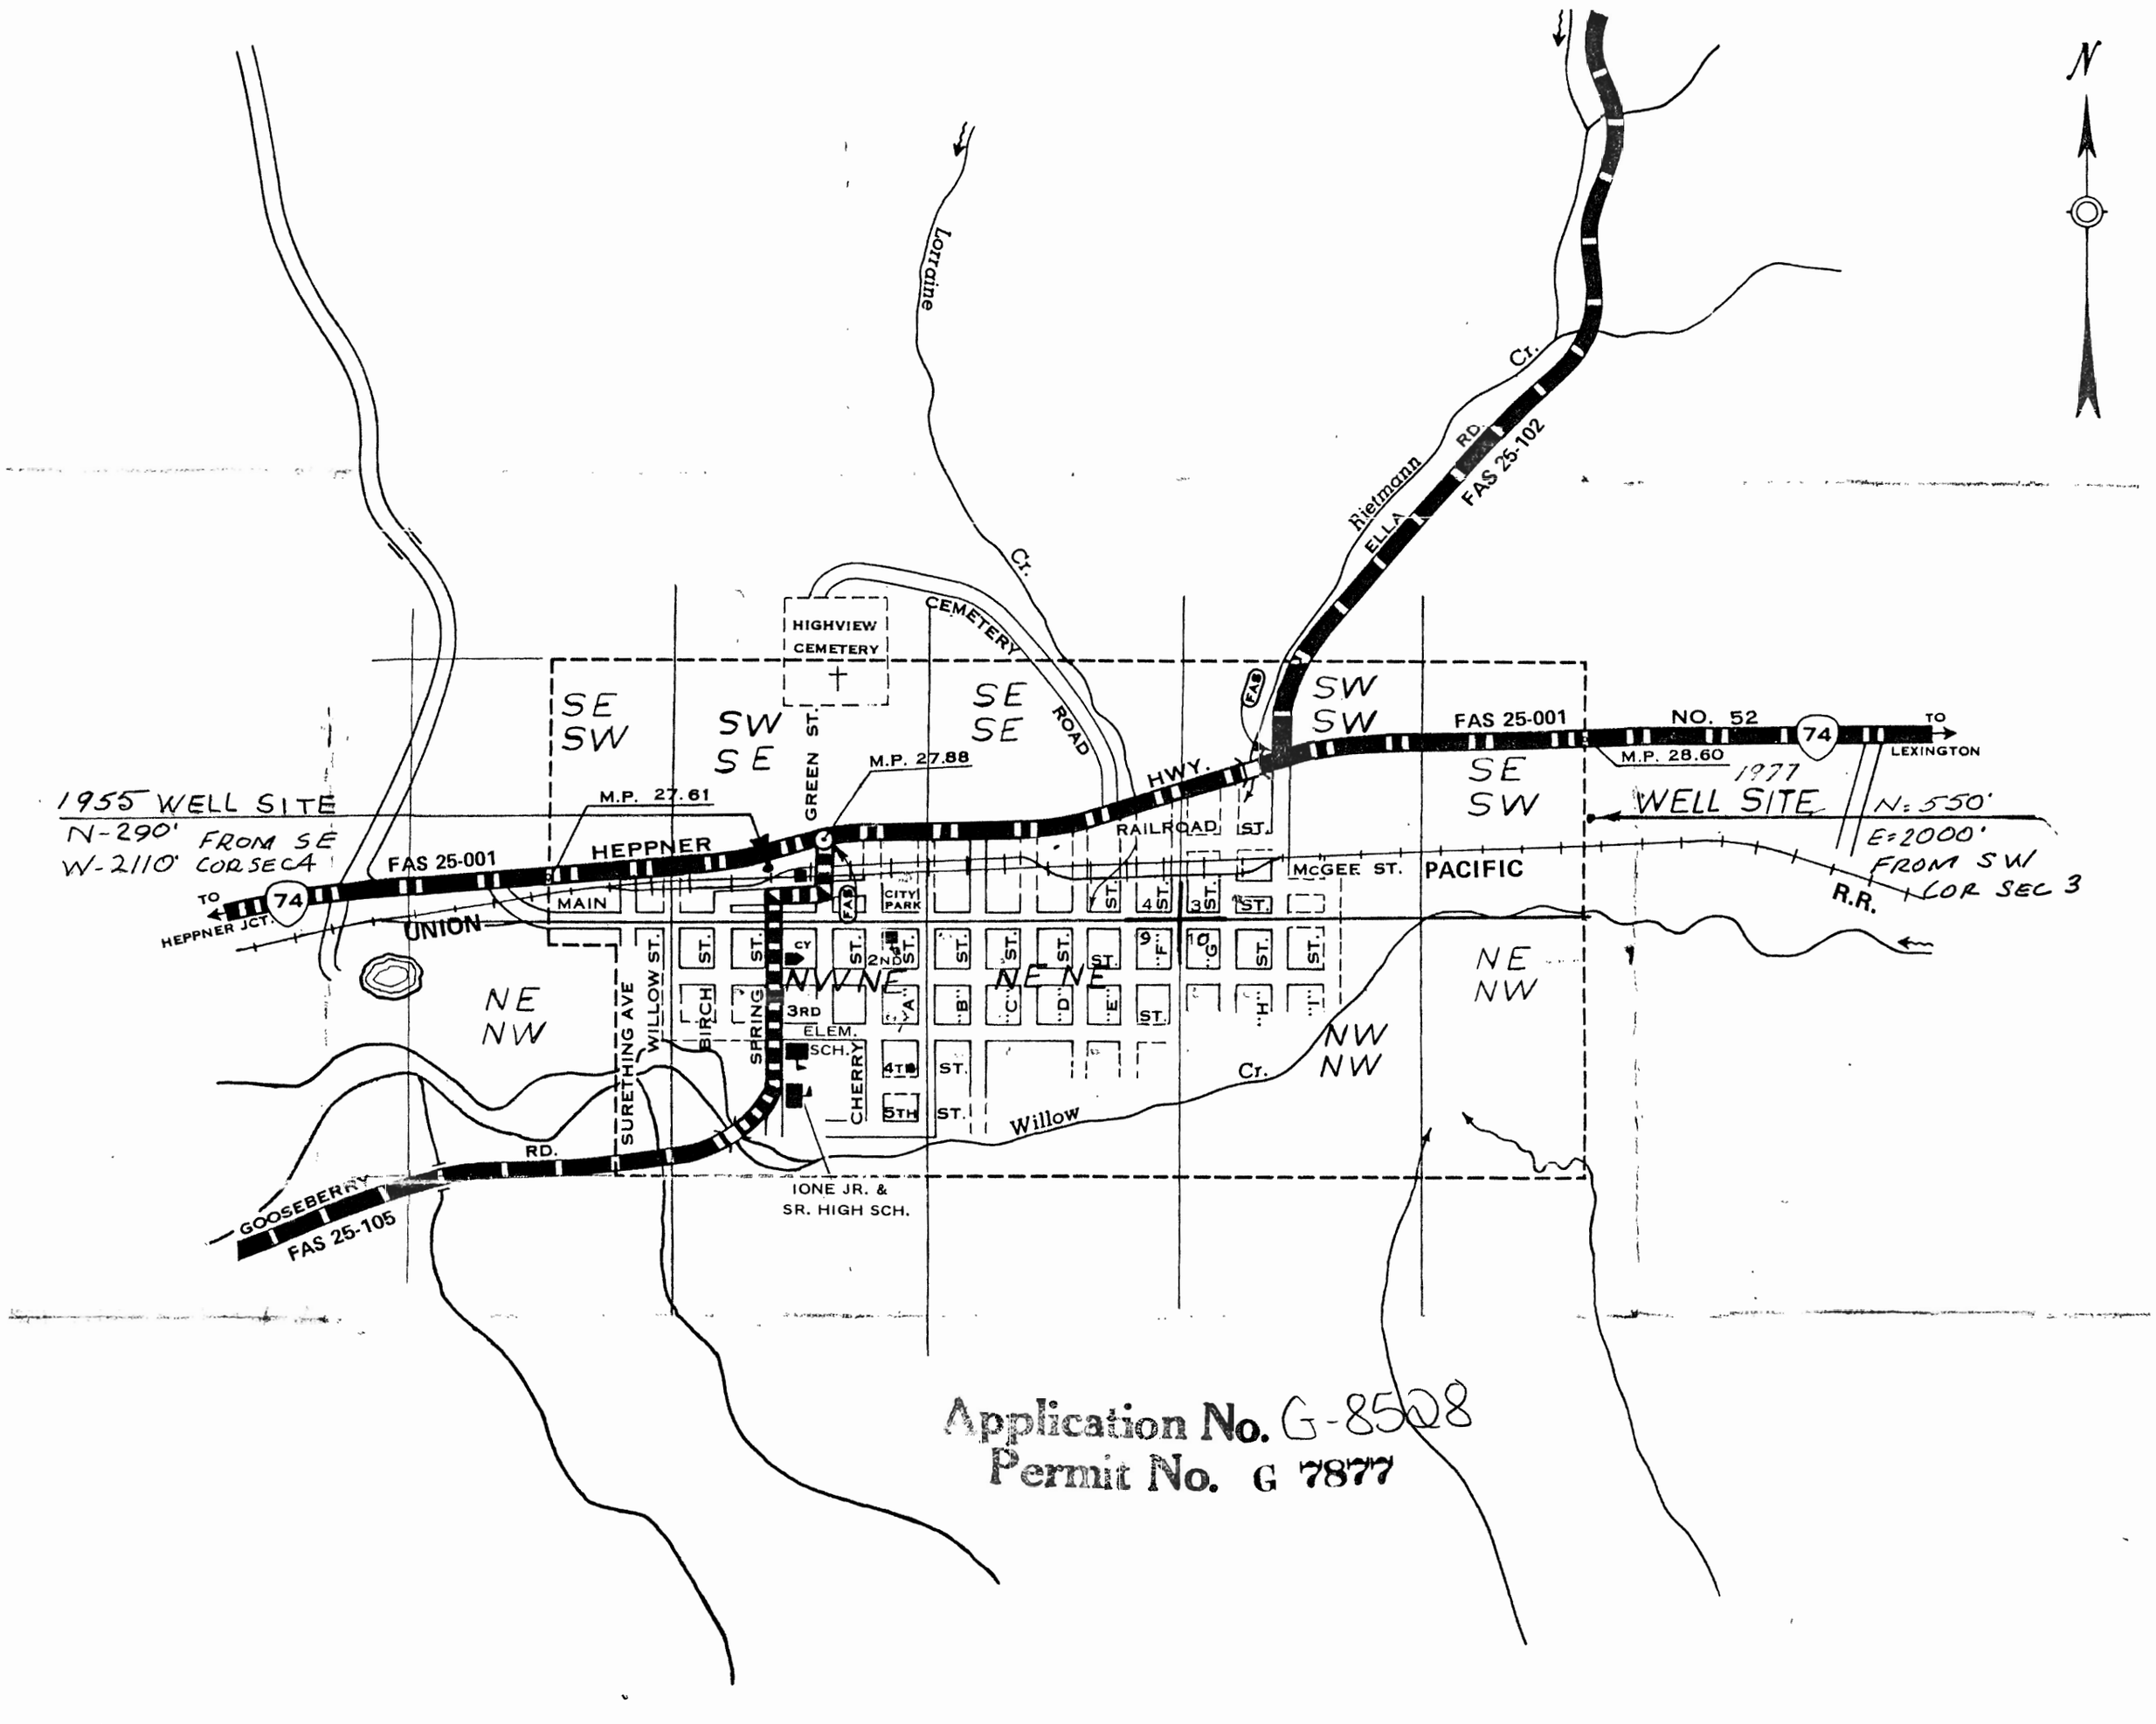

Application No. G-8528
Permit No. G 7877

T1S. R24E W.M.

RECEIVED
NOV 18 1977
WATER RESOURCES DEPT
SALEM, OREGON

IONE

MORROW COUNTY, OREGON

PREPARED BY THE
OREGON STATE HIGHWAY DIVISION
IN COOPERATION WITH
U.S. DEPARTMENT OF TRANSPORTATION
FEDERAL HIGHWAY ADMINISTRATION

Population 385

Scale in Feet

0 400 800

LEGEND

- FAI — FEDERAL AID INTERSTATE SYSTEM
- FAP — FEDERAL AID PRIMARY SYSTEM
- FAS — FEDERAL AID SECONDARY SYSTEM - STATE
- FAS — FEDERAL AID SECONDARY SYSTEM - COUNTY
- FAS — OTHER FEDERAL AID SECONDARY - LOCAL
- FAS — TERMINATION OF FA SYSTEM
- TERMINATION OF ROUTE
- DIVIDED HIGHWAY
- 4 — UNDIVIDED HIGHWAY - NO. OF LANES
- STREET OPEN FOR TRAVEL
- STREET DEDICATED BUT NOT OPEN
- INTERSTATE NUMBERED ROUTE (FAI)
- U.S. NUMBERED ROUTE
- STATE NUMBERED ROUTE
- POST OFFICE
- SCHOOL
- CITY CENTER
- R.R. DEPOT
- CITY LIMITS
- PUBLIC BLDG.
- CY — CITY HALL
- CT — COURT HOUSE
- A — ARMORY
- L — LIBRARY