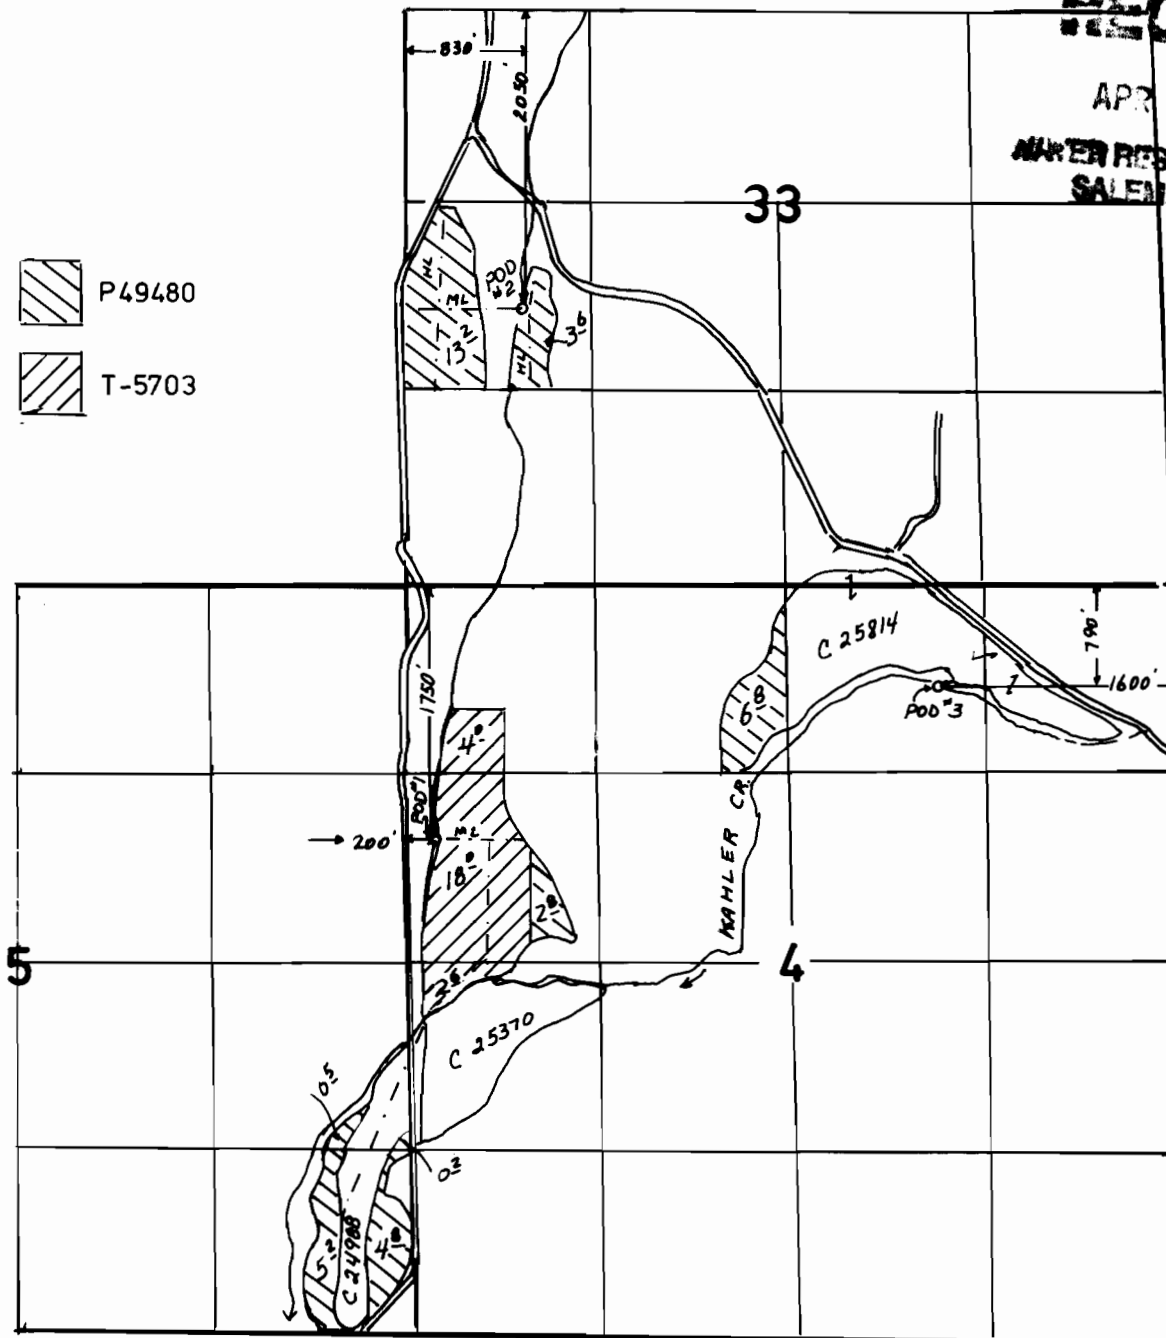


WATER RESOURCES DE-
SALEM, OREGON


$$1'' = 1320'$$

FINAL PROOF SURVEY

UNDER

TRANSFER NO.5703

Application No. 68549... Permit No. 49480.....
IN NAME OF

.....ROBERT W. STRAUB.....

Surveyed ..6-13.... 2000, by ..J..MILLER.....