



Application No. @ 9364
 Permit No.

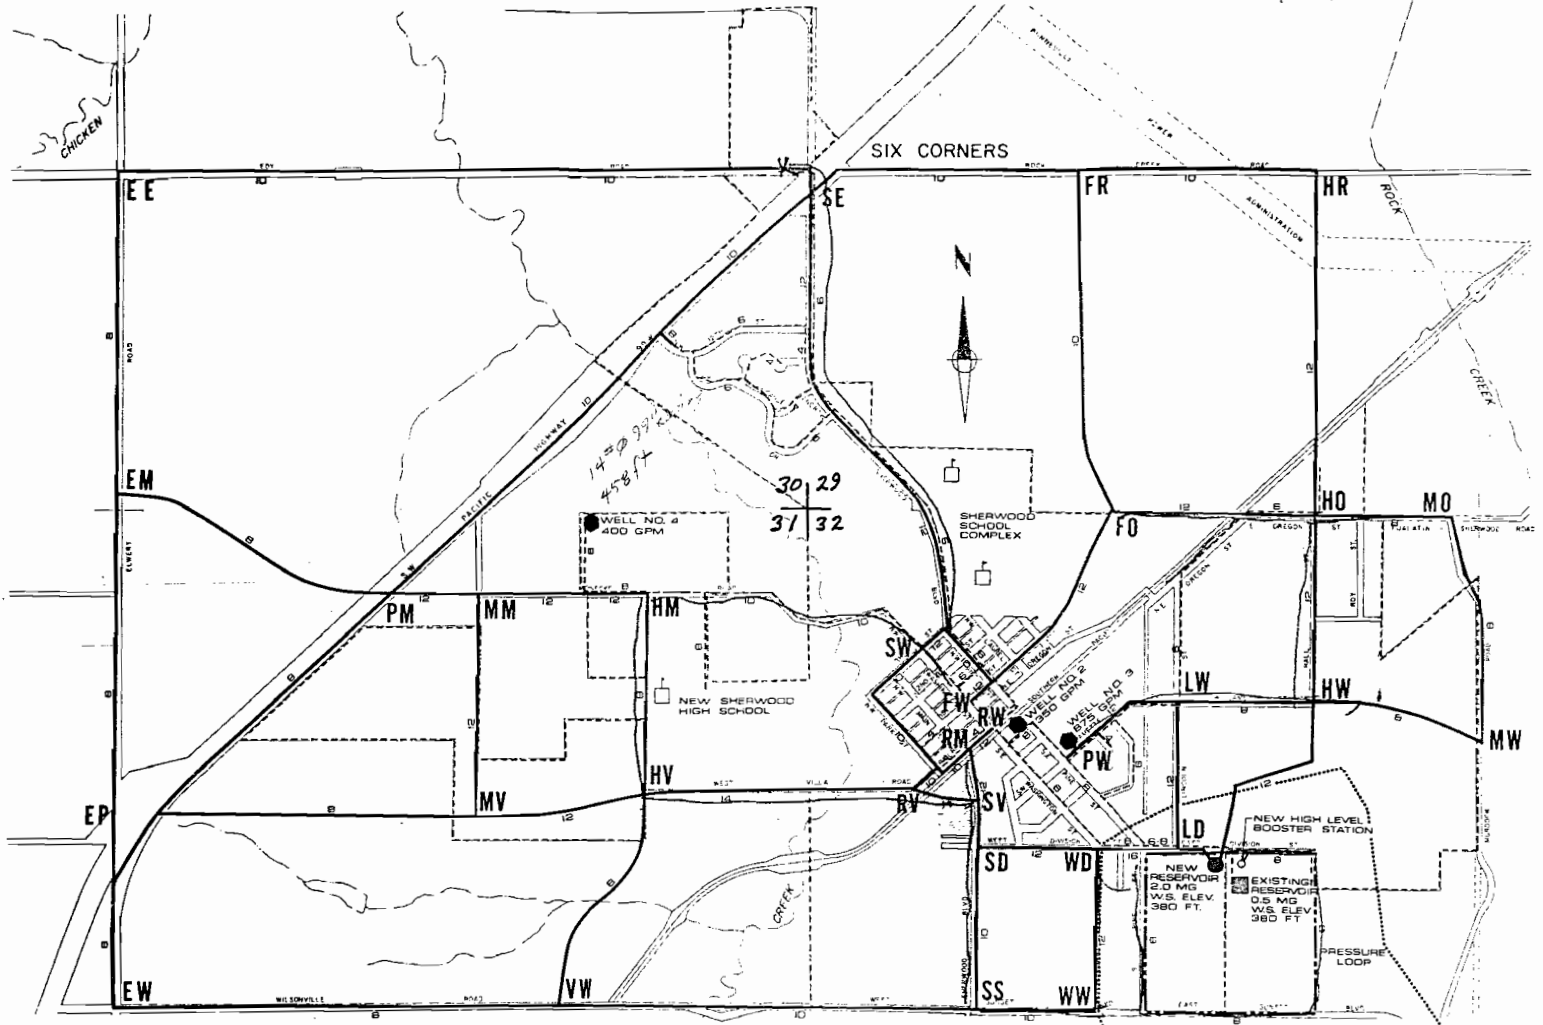

- LEGEND**
- 2 --- EXISTING MAINS
 - 10 --- PROPOSED MAINS
 - 8 --- PROPOSED PRESSURE LOOP
 - APPROX. LIMITS OF HIGH LEVEL PRESSURE SYSTEM

70.0
 30.0
 5.25
 7.25

	 <p>ROBERT E. MEYER ENGINEERS INC 1430 E. W. ALLEN BOULEVARD BEAVERTON, OREGON 97005 PHONE (503) 440-3193</p>	<p>WATER STUDY SHERWOOD, OREGON</p>	<p>EXHIBIT "A" DISTRIBUTION SYSTEM IMPROVEMENTS</p>	<p>PLATE 1 OF 60</p>
BY: _____ DATE: _____	REVISION: _____	DESIGN: LNP DRAWN: H.A.B. CHECKED: _____	DATE: MAY 07/71 SCALE: GRAPHIC	APPROVED BY: _____