



T. 7 & 8 N R. 4 W W.M.

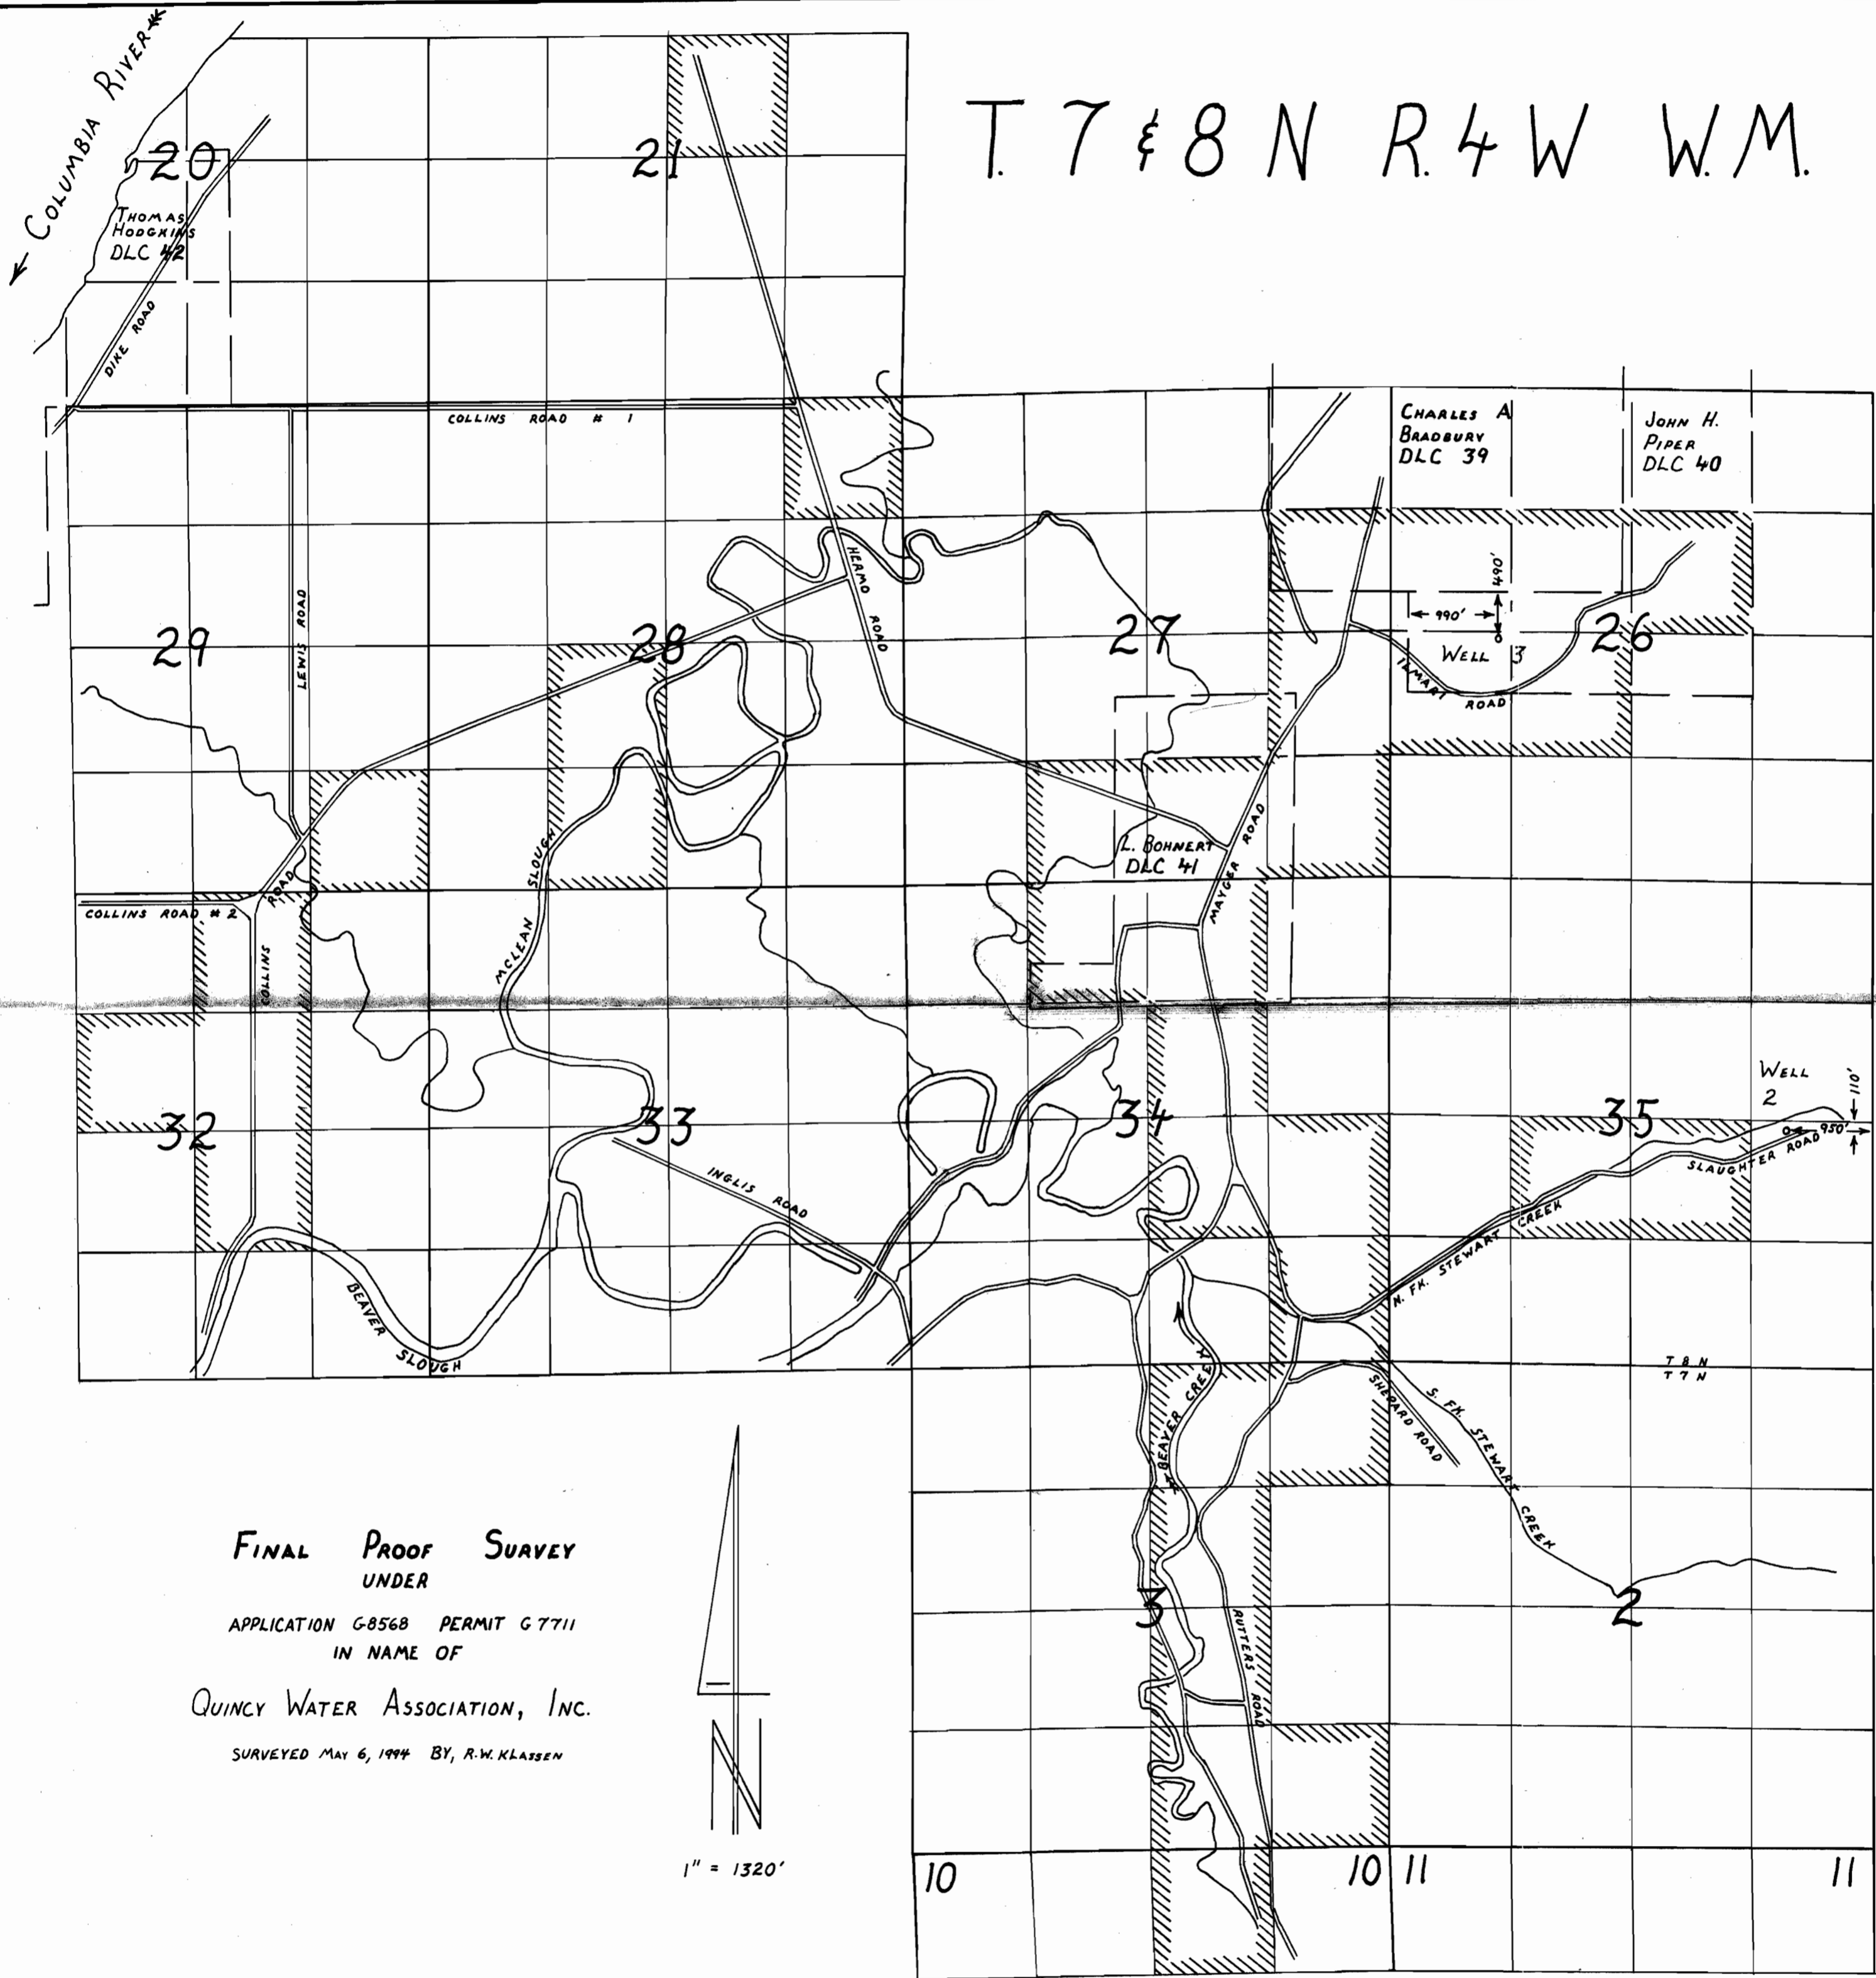

FINAL PROOF SURVEY
UNDER
APPLICATION G8568 PERMIT G7711
IN NAME OF
QUINCY WATER ASSOCIATION, INC.
SURVEYED MAY 6, 1994 BY, R.W. KLASSEN

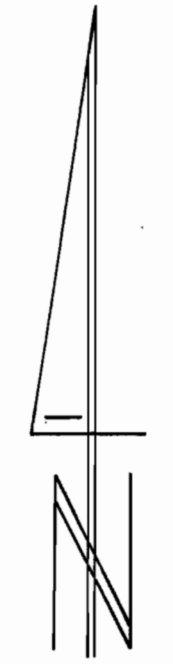

1" = 1320'