




Application No. *L-61107*
Permit No. **R 8357**

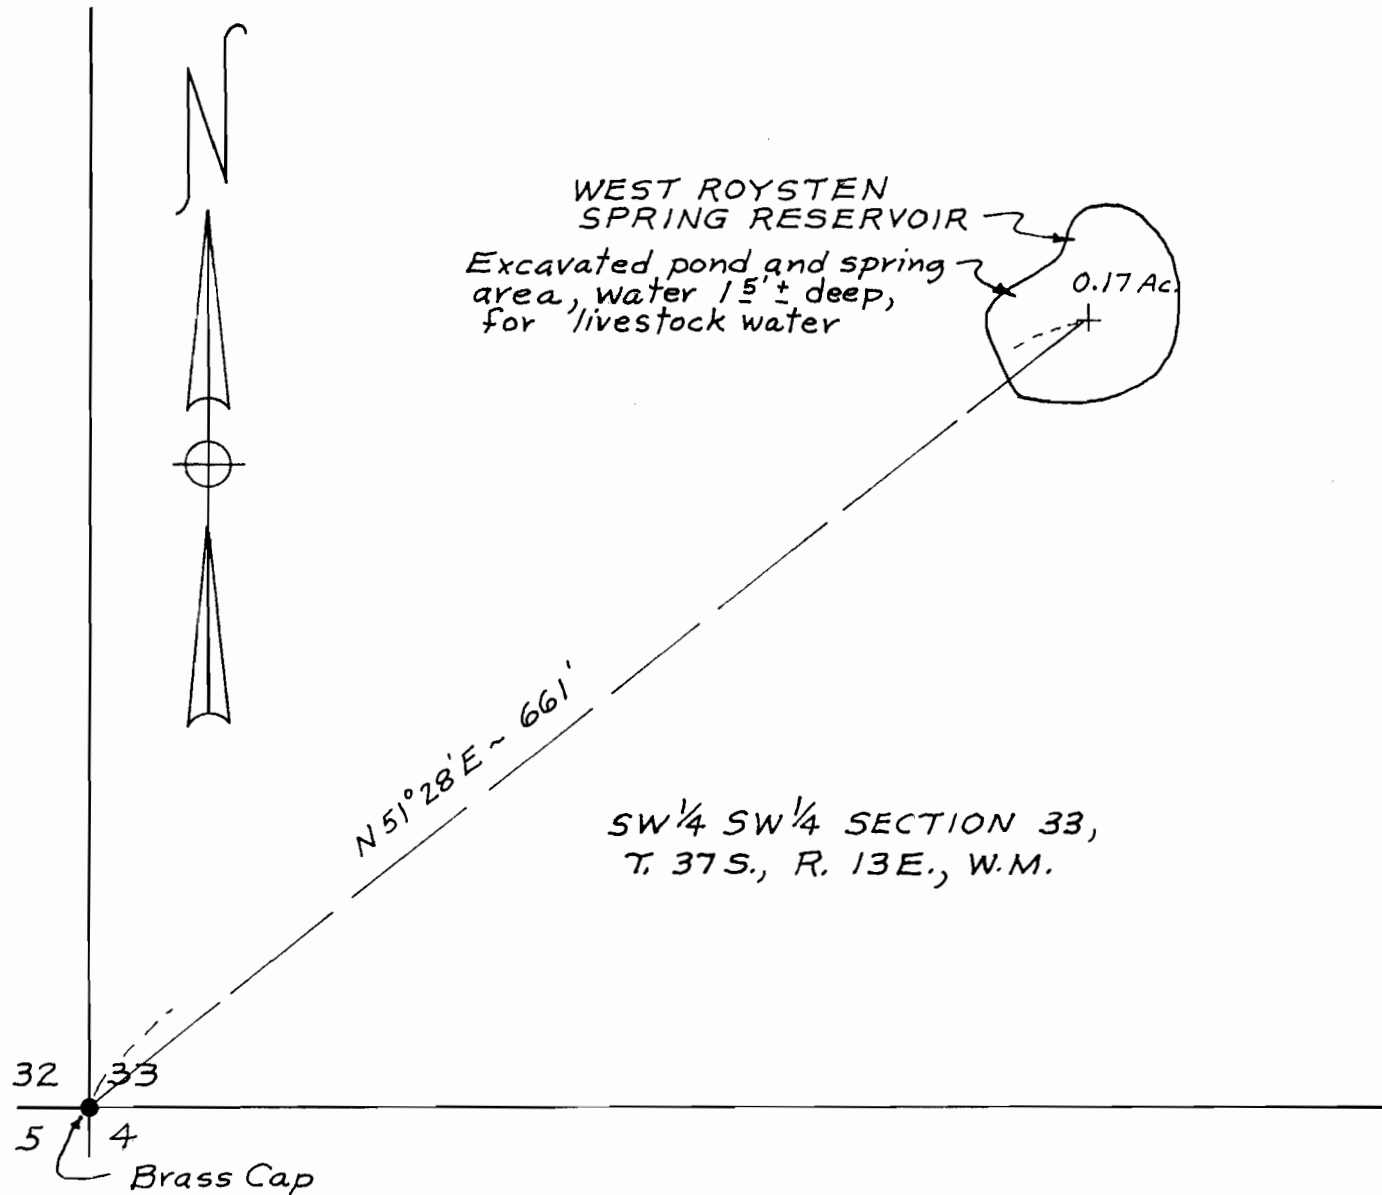

MAP SHOWING
WEST ROYSTEN SPRING RESERVOIR
FOR WILLIAMS LAND COMPANY
IN SW 1/4 SW 1/4 SEC. 33, T. 37 S., R. 13 E., W.M.
KLAMATH COUNTY, OREGON

Scale: 1" = 100'
Map prepared by: WILLIAM L. WALES
& Associates
Consulting Engineers
1740 Austin Street
Klamath Falls, Oregon

December, 1980