


T. 22 S., R. 4 W., W. M.

SECTION 31

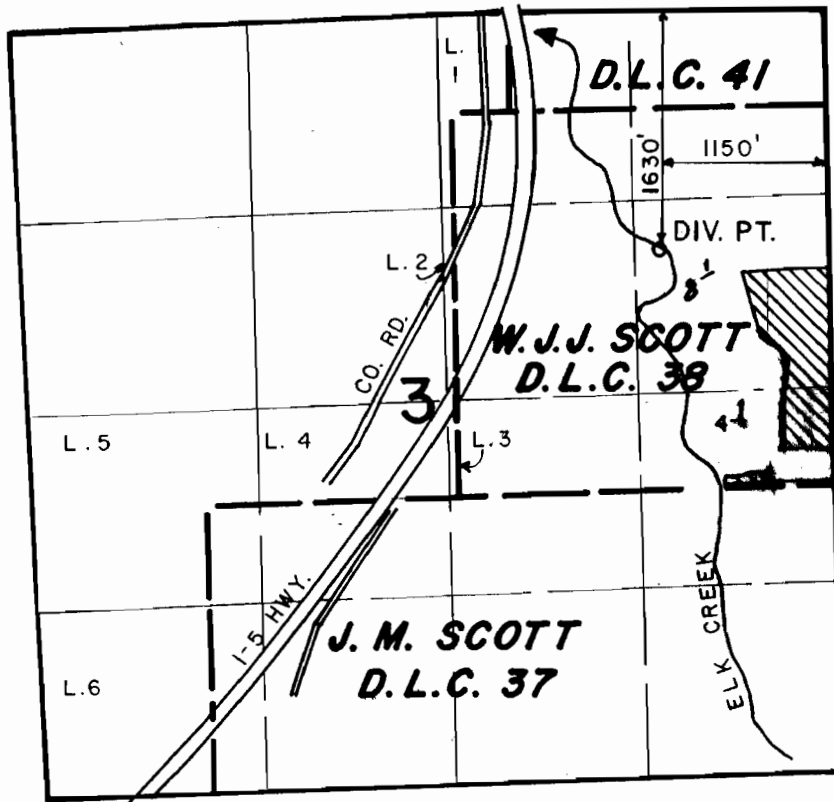

SCALE: 4" = 1 MILE

**FINAL PROOF SURVEY**  
UNDER

TRANSFER NUMBER 3745

IN NAME OF

**ROGER E. JOHNSTON**

Surveyed AUG. 11, 1988, by J.M. SCHMORDE