
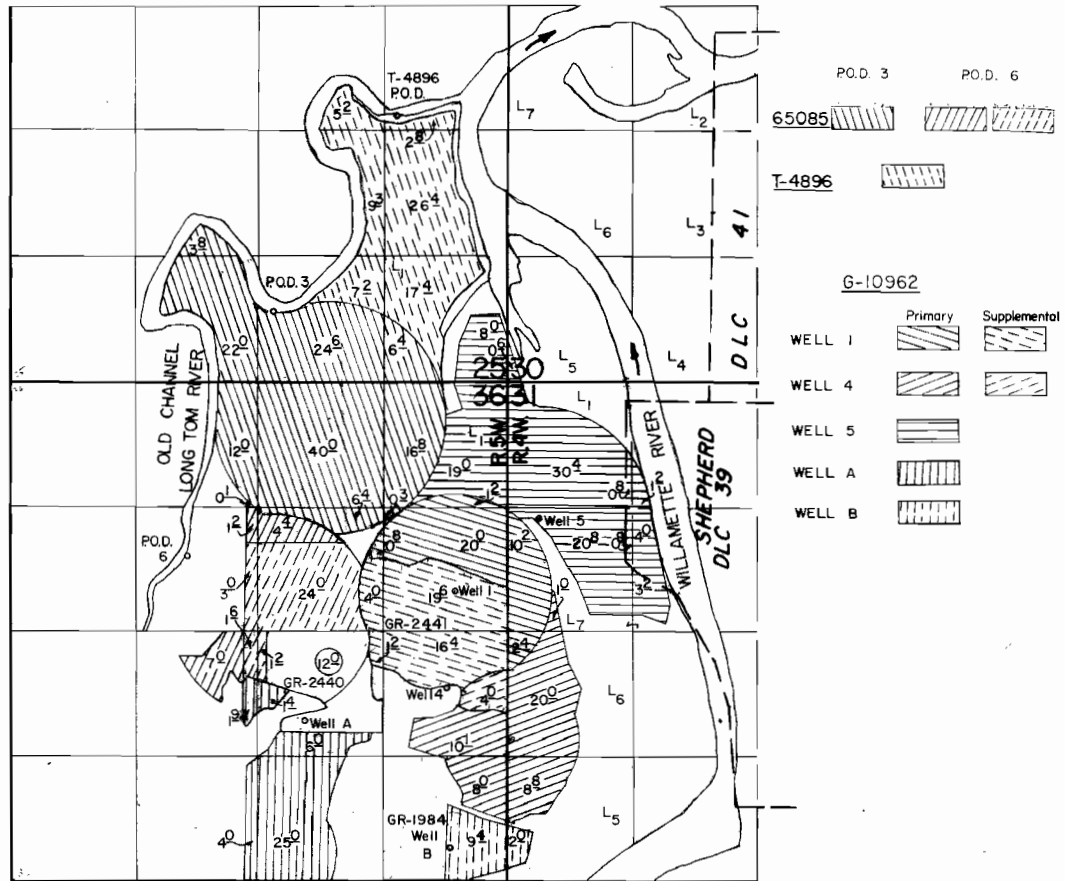


T. 13 S., R. 4. & 5 W., W.M.

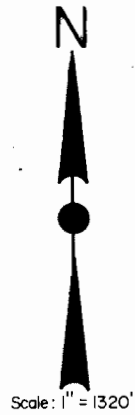

T-4896 P.O.D. Loc.: 2800' N. & 1460' E. from S. 1/4 Cor. Sec. 25.
 65085 P.O.D. Loc.: 3-740' N. & 170' E.
 6-1840' S. & 740' W., both from N. 1/4 Cor. Sec. 36.

G-10962 Well Loc.: Well 1- 400' N. & 550' W.
 Well 4- 600' S. & 650' W.
 Well 5- 1190' N. & 340' E.
 Well A- 950' S. & 2150' W.
 Well B- 2300' S. & 600' W. ; all from E. 1/4 Cor. Sec. 36.

FINAL PROOF SURVEY

UNDER
 TRANSFER 4896

Application No. G-10962 Permit No. G-10063
 65085 47570

IN NAME OF

GEORGE HORNING

Surveyed August 24, 1988, by T. M. Warren