


# T. 5 S. R. 1 E. W. M.

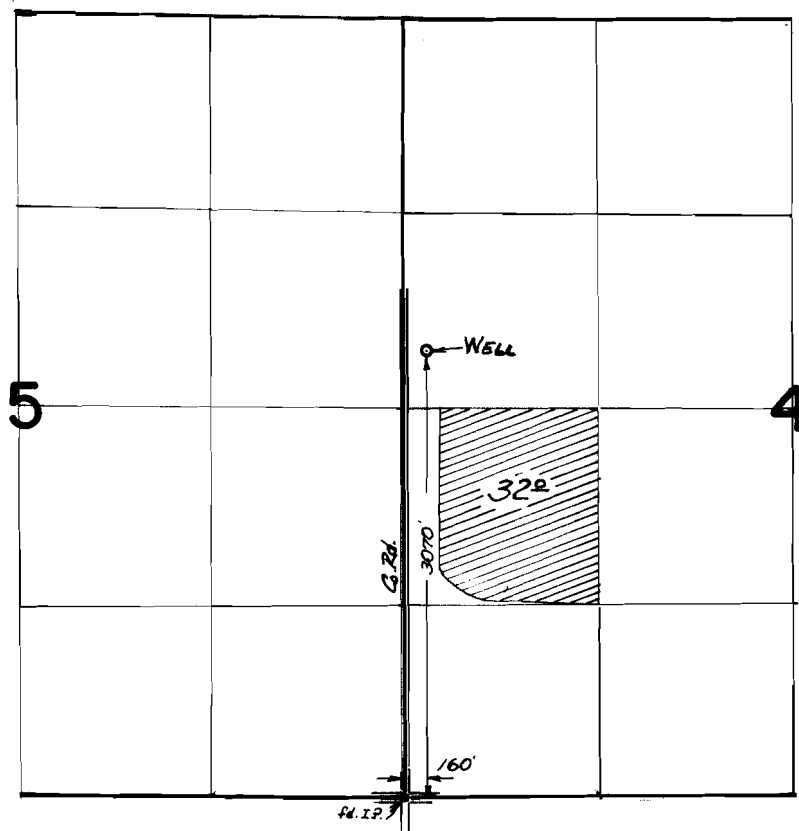

## FINAL PROOF SURVEY UNDER

Application No. G. 5045... Permit No. G. 4755.....  
IN NAME OF

.....LORIN L. YODER.....

Surveyed 2. OCT. .... 1970., by L. E. GOULD.....