


T. 21 S., R. 36 E., W.M.

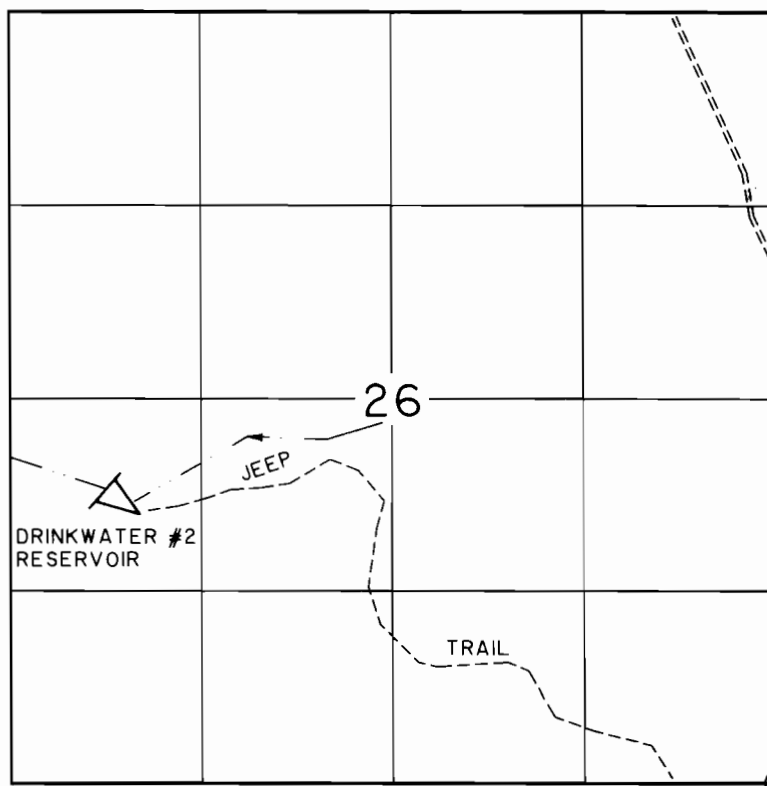

1" = 1320'

DIVERSION IS LOCATED
2015 FEET NORTH AND
4625 FEET WEST OF THE
SE SECTION CORNER.


FINAL PROOF MAP

IN NAME OF

UNITED STATES BUREAU OF LAND MANAGEMENT

APPLICATION NO. R-49488

PERMIT NO. R-7910

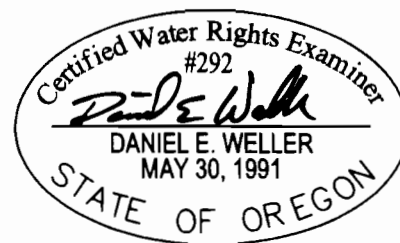

SURVEYED: MAY 1, 2001

EXPIRES: JUNE 30, 2004

THE PURPOSE OF THIS MAP IS FOR IDENTIFYING THE LOCATION OF THE WATER RIGHT ONLY AND
IS NOT INTENDED TO PROVIDE LEGAL DIMENSIONS OR LOCATION OF PROPERTY OWNERSHIP LINES.

BLM PROJECT NO. 4257

U.S. BUREAU OF LAND MANAGEMENT-OSO
BRANCH OF CADASTRAL SURVEY

DWG: DRINKWATER2

EXECUTED BY:
DANIEL E. WELLER, PLS, CWRE
P.O. BOX 2965
PORTLAND, OREGON 97208