


T. 21 S., R. 36 E., W.M.

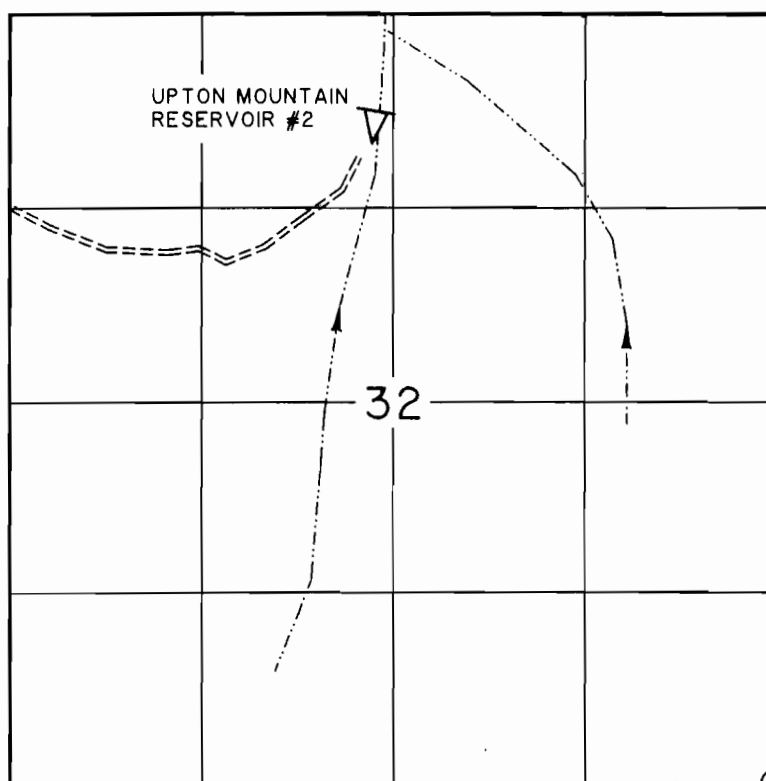

1" = 1320'

DIVERSION IS LOCATED
4640 FEET NORTH AND
2825 FEET WEST OF THE
SE SECTION CORNER.


FINAL PROOF MAP

IN NAME OF

UNITED STATES BUREAU OF LAND MANAGEMENT

APPLICATION NO. R-49489

PERMIT NO. R-7911

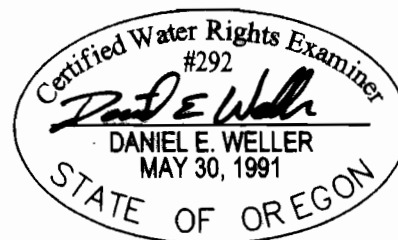

EXPIRES: JUNE 30, 2004

SURVEYED: MAY 2, 2001

THE PURPOSE OF THIS MAP IS FOR IDENTIFYING THE LOCATION OF THE WATER RIGHT ONLY AND
IS NOT INTENDED TO PROVIDE LEGAL DIMENSIONS OR LOCATION OF PROPERTY OWNERSHIP LINES.

BLM PROJECT NO. 4171

U.S. BUREAU OF LAND MANAGEMENT-OSO
BRANCH OF CADASTRAL SURVEY

DWG: UPTON#2

EXECUTED BY:
DANIEL E. WELLER, PLS, CWRE
P.O. BOX 2965
PORTLAND, OREGON 97208