


T. 21 S., R. 36 E., W.M.

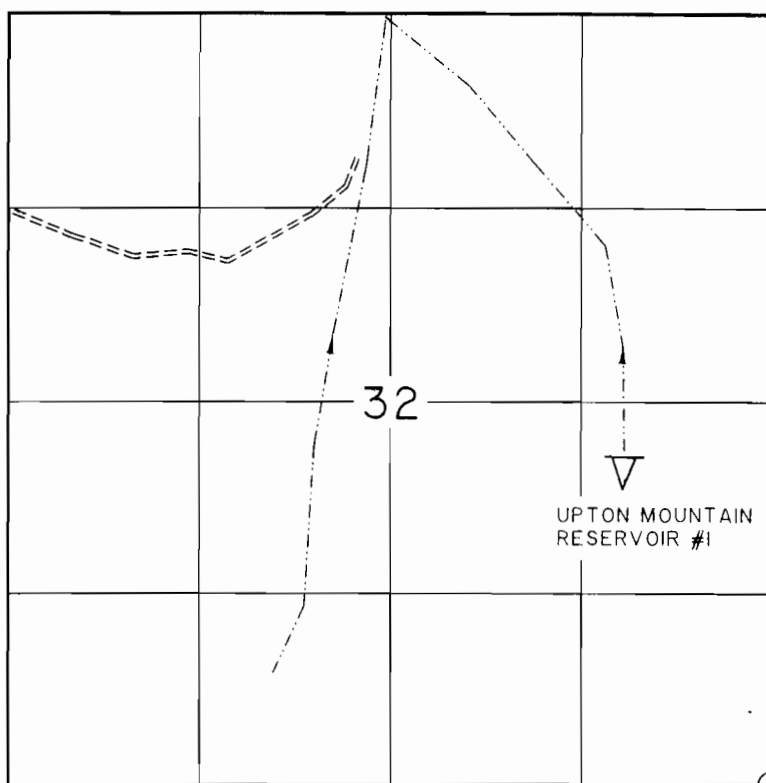

1" = 1320'

DIVERSION IS LOCATED
2265 FEET NORTH AND
1050 FEET WEST OF THE
SE SECTION CORNER.


FINAL PROOF MAP

IN NAME OF

UNITED STATES BUREAU OF LAND MANAGEMENT

APPLICATION NO. R-49493

PERMIT NO. R-7913

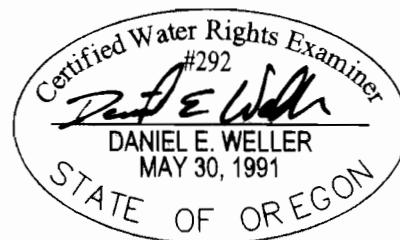

SURVEYED: MAY 2, 2001

EXPIRES: JUNE 30, 2004

THE PURPOSE OF THIS MAP IS FOR IDENTIFYING THE LOCATION OF THE WATER RIGHT ONLY AND
IS NOT INTENDED TO PROVIDE LEGAL DIMENSIONS OR LOCATION OF PROPERTY OWNERSHIP LINES.

BLM PROJECT NO. 4172

U.S. BUREAU OF LAND MANAGEMENT-OSO
BRANCH OF CADASTRAL SURVEY

DWG: UPTON#1

EXECUTED BY:
DANIEL E. WELLER, PLS, CWRE
P.O. BOX 2965
PORTLAND, OREGON 97208