


T. 11 S., R. 20 E., W.M.

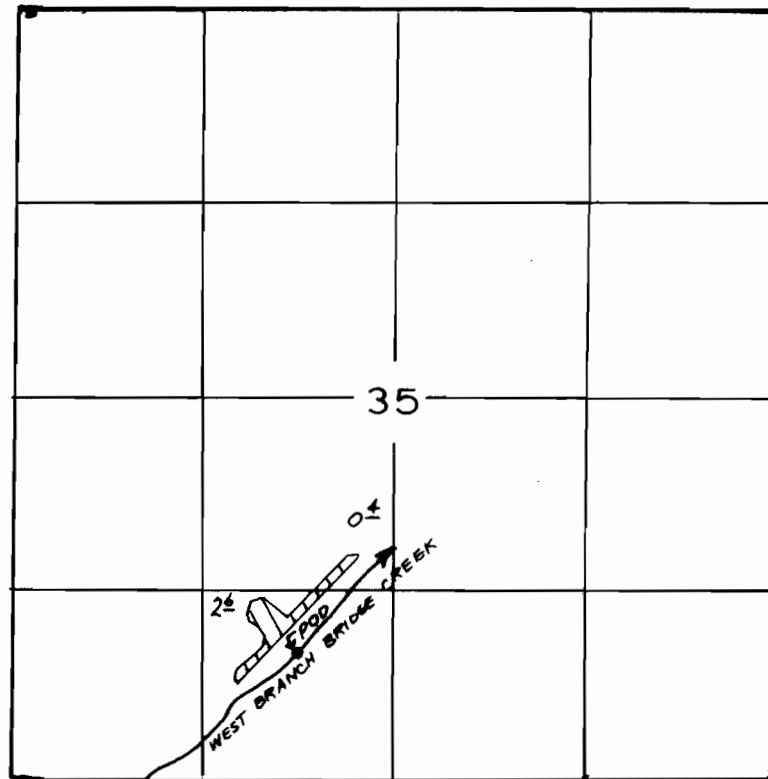

POD - 820' N. & 620' W. FROM THE S 1/4 CORNER SEC. 35.



1"=1320'

FINAL PROOF SURVEY

UNDER

Application No. 66899 Permit No. 48110
IN NAME OF

MARVIN AND PHYLLIS HALSTEAD

Surveyed 9-10, 1992, by J. MILLER