

R17E

R18E

R19E


T38S

T39S

T. 38 S

 Permit No. 50481

○ = WATER SOURCE  
 — = WATER USE

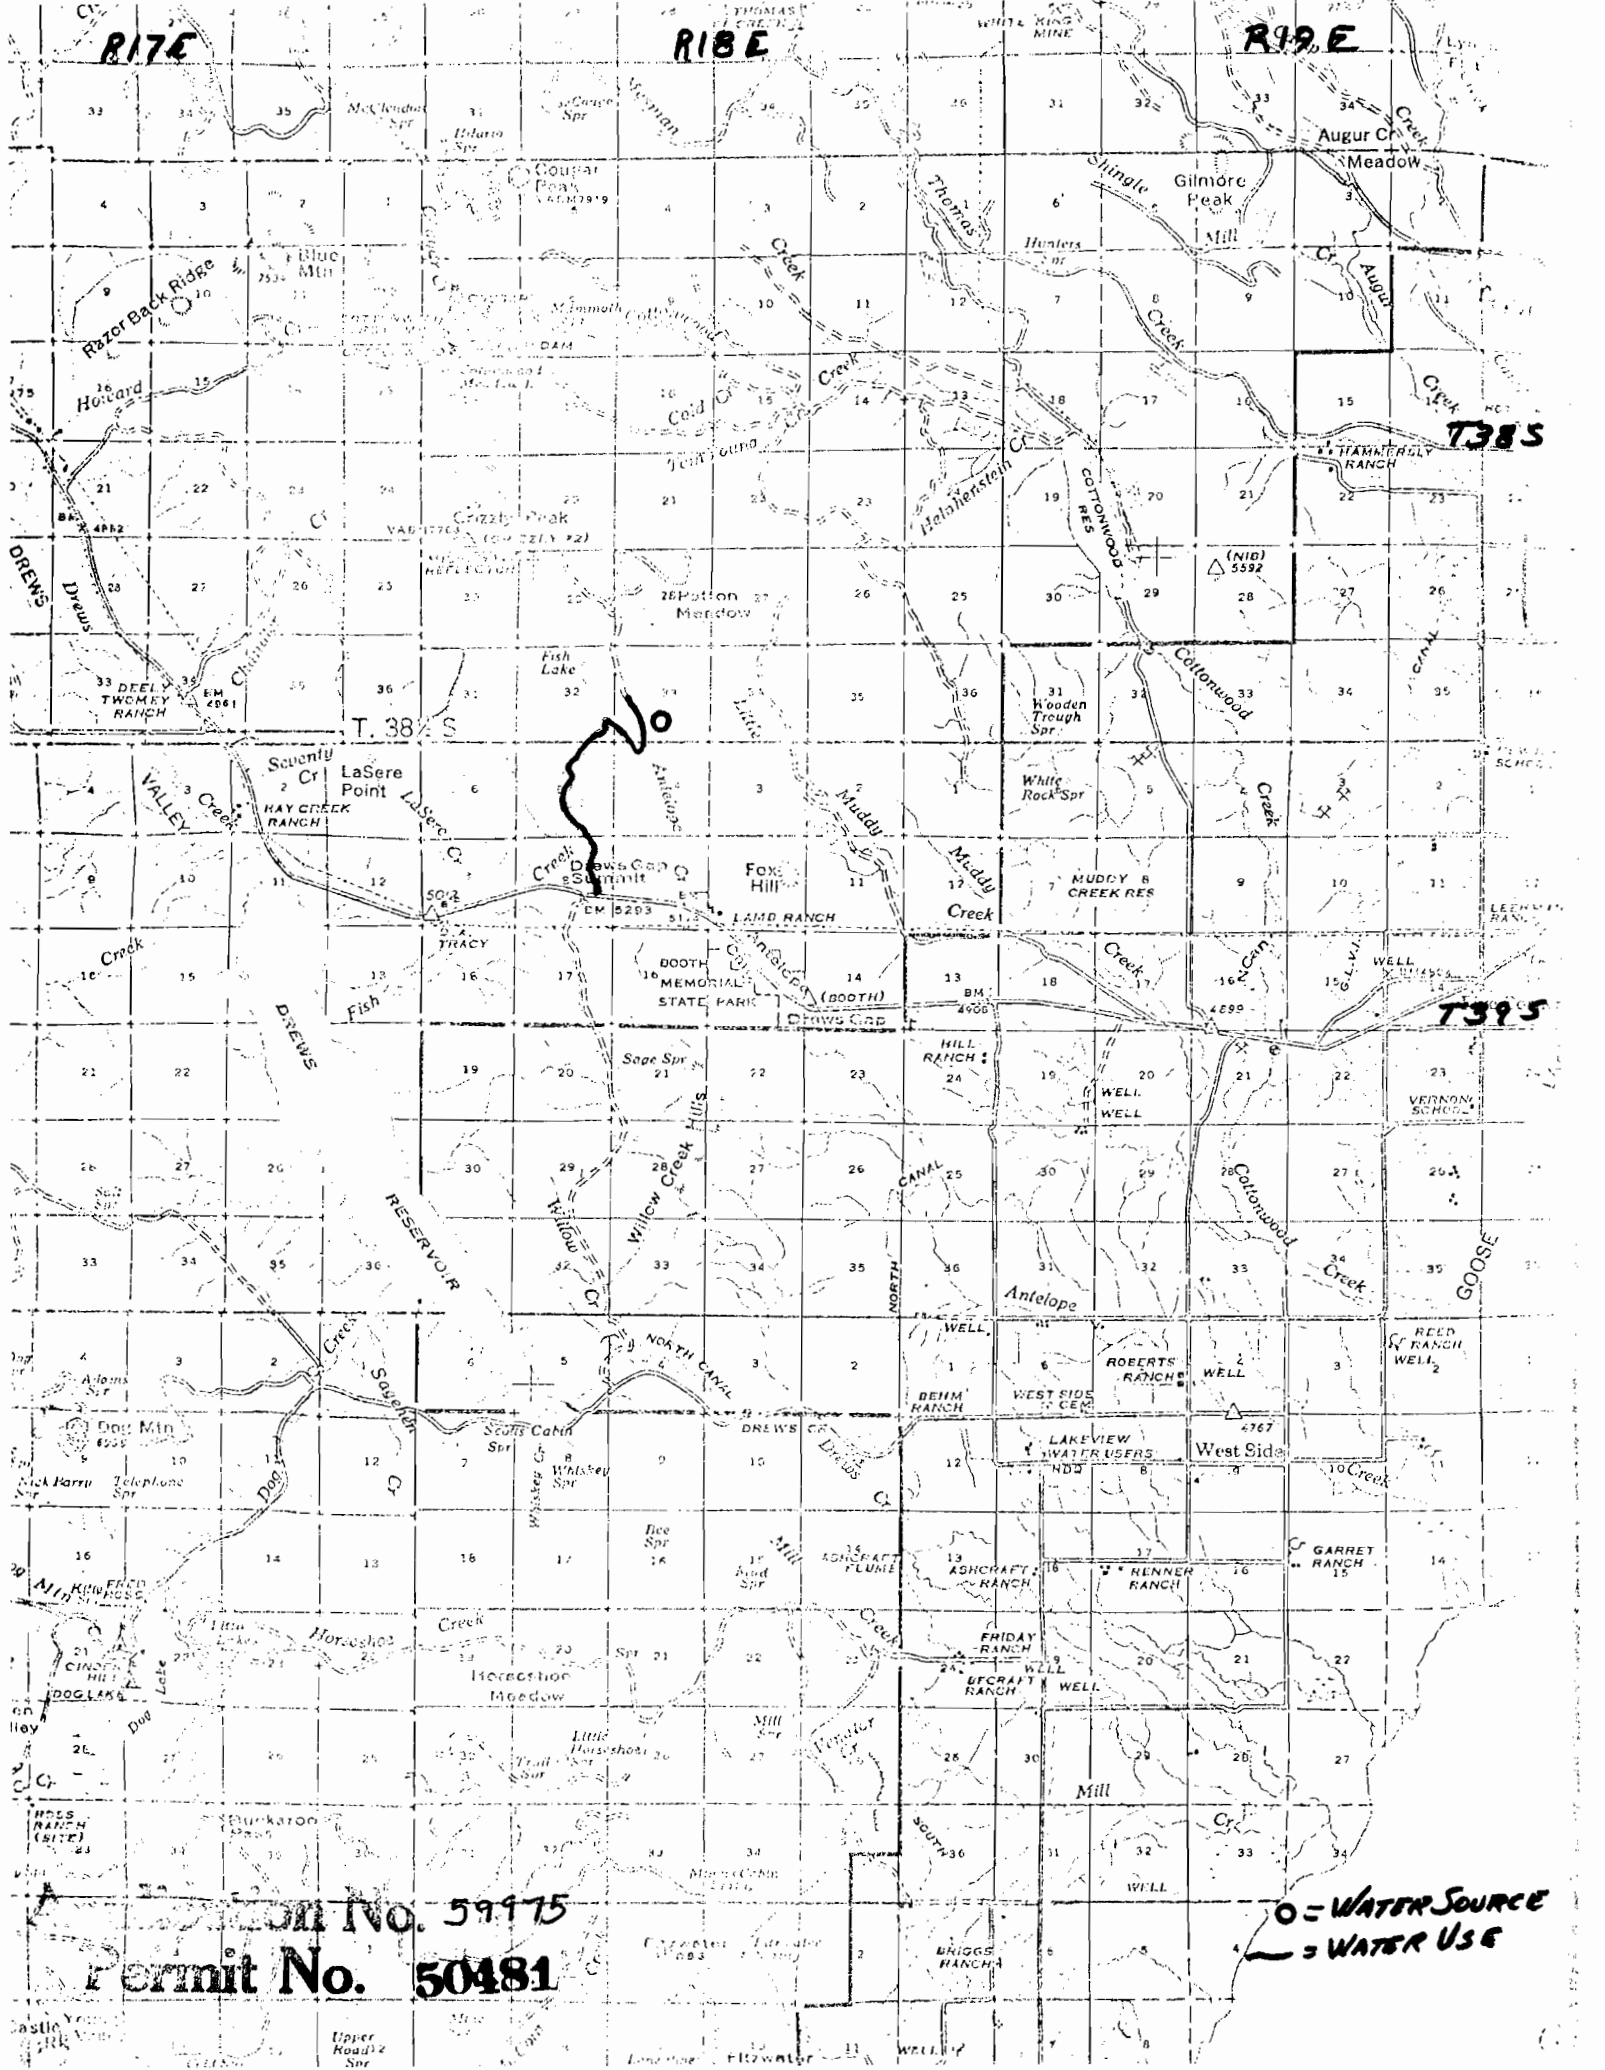

# FIELD MAP SHEET

RECEIVED  
APR 11 1930  
WATER RESOURCES DEPT  
FRENCH CREEK  
OREGON

T. 38s R. 18E Sec. 33 Subdiv. SE 1/4-SW 1/4

Scale 8.2 inches = 1 Mile

APPLICATION NO. 59975

PERMIT NO. \_\_\_\_\_

⊙ = WATER SOURCE

Application No. 59975

Permit No. 50481

NORTH

