


T.38S.,R.48&5W.,W.M.

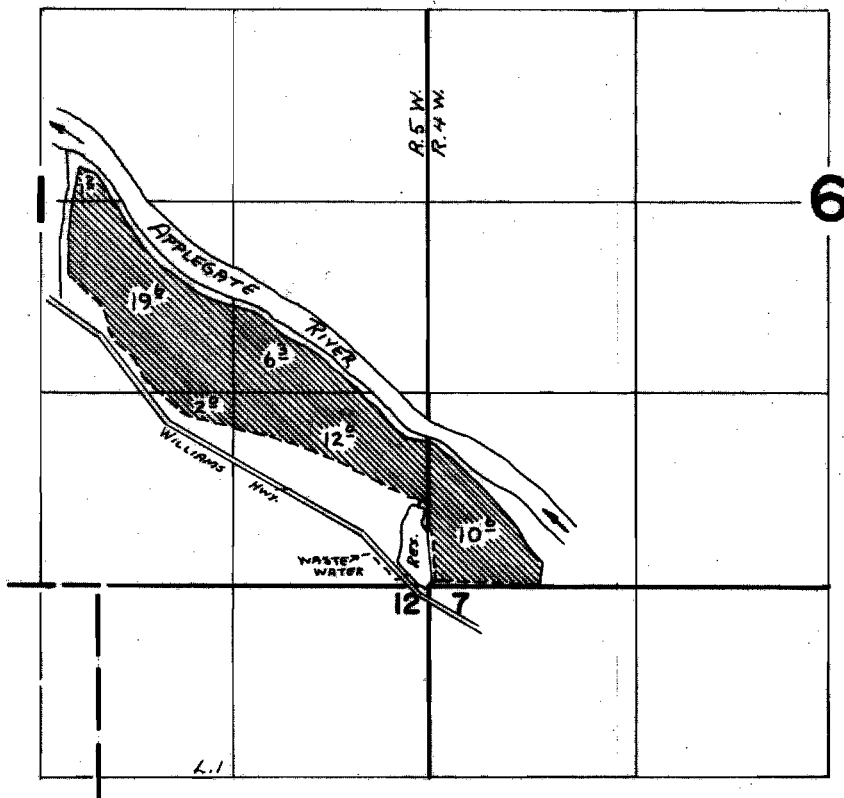

**FINAL PROOF SURVEY**  
UNDER

R-47599                      R-5734  
Application No. 47600    Permit No. 35629  
IN NAME OF

ESTATE OF ELERY STONE

Surveyed SEPT. 17 1974, by L. TOLL