


T. 12 S., R. 21 E., W.M.

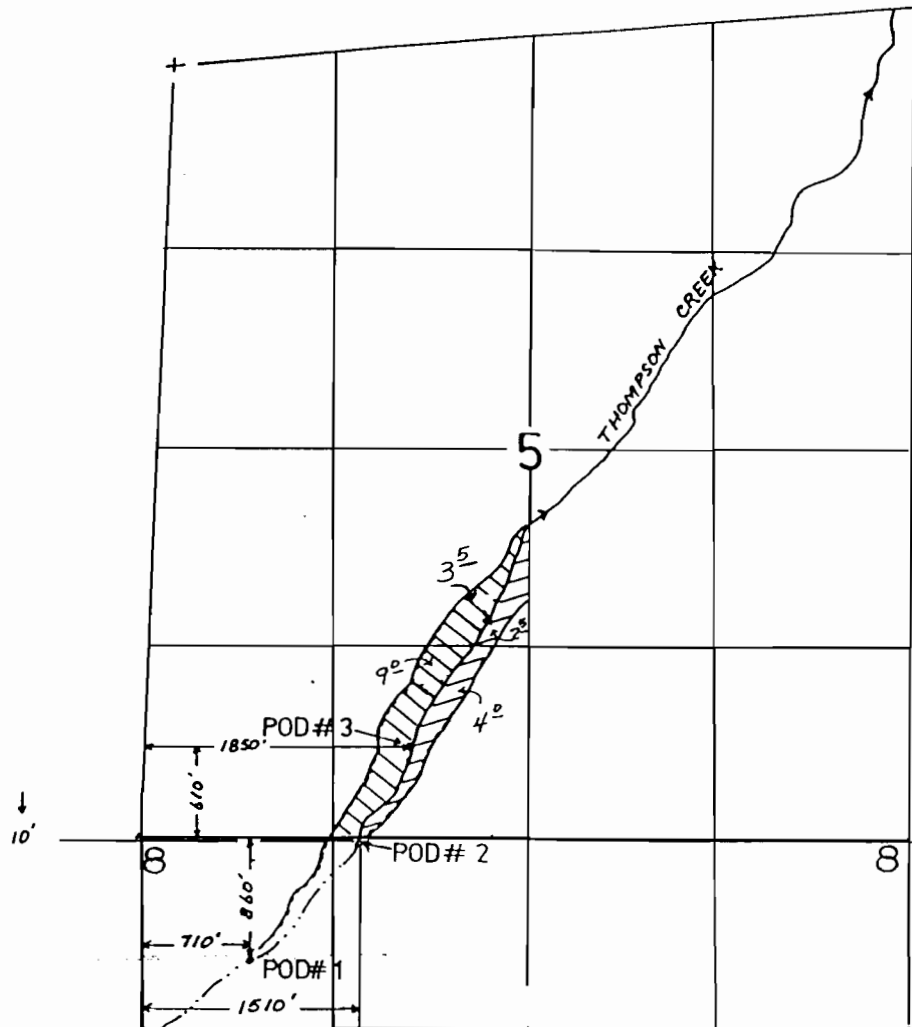

IRRIGATION FROM
POD #1 OR #3



IRRIGATION FROM
POD #2



FINAL PROOF SURVEY

UNDER

Application No. 63815 Permit No. 47040

IN NAME OF

ROBERT AND CAROLYN POWELL

Surveyed 9-10, 1992, by J. MILLER

PRELIMINARY
SUBJECT TO REVISION

REVISED 4-25-01
41069-179-258 R JM 5-17-95