


T. 7 & 8 S. R. 1 E. W. M.

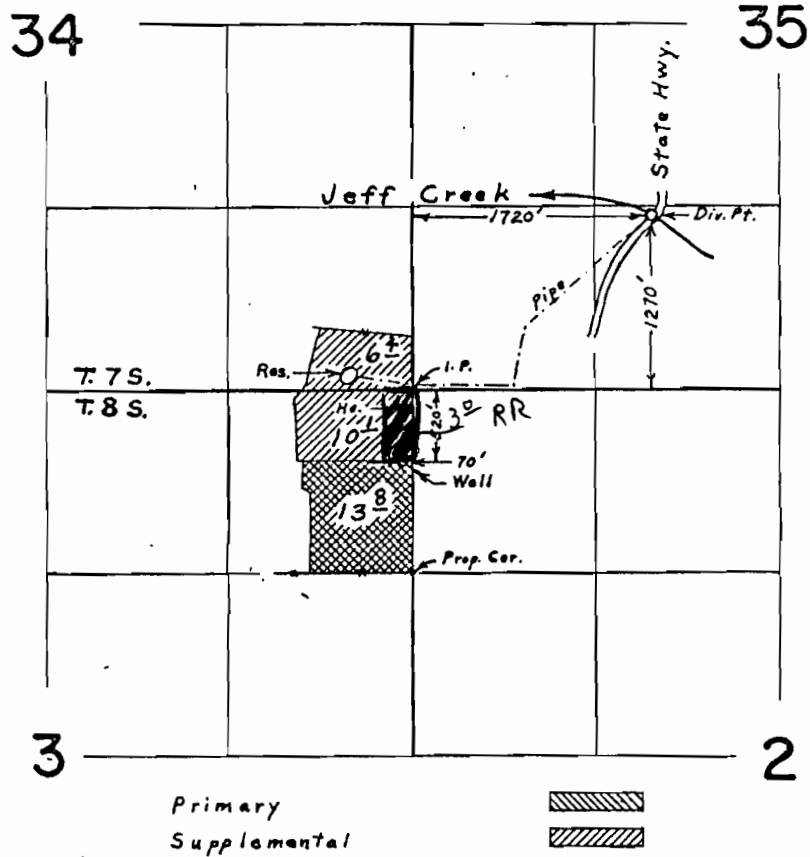

FINAL PROOF SURVEY UNDER

G-4067 G-3812
 Application No. 43813 Permit No. 32756
 IN NAME OF

RALPH A. & MARIAN B. JACK

Surveyed July 26, 1968, by L. E. Gould
 Aug. 15,