


# T. 6 S., R. 1 W., W.M.

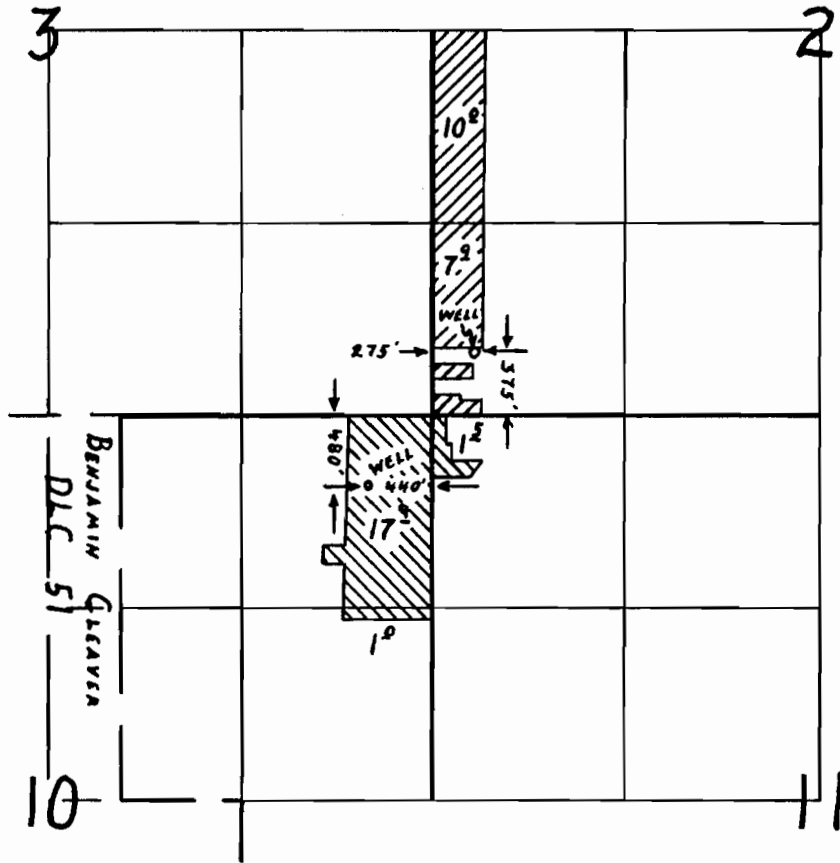

## FINAL PROOF SURVEY

UNDER

Application No. G-11510 Permit No. G-10619  
G-11527 G-10622



IN NAME OF

ALAN J. KRAEMER

Surveyed JUNE 16, 1992, by R.W.Klassen