


T. 6 S., R. 1 W., W.M.

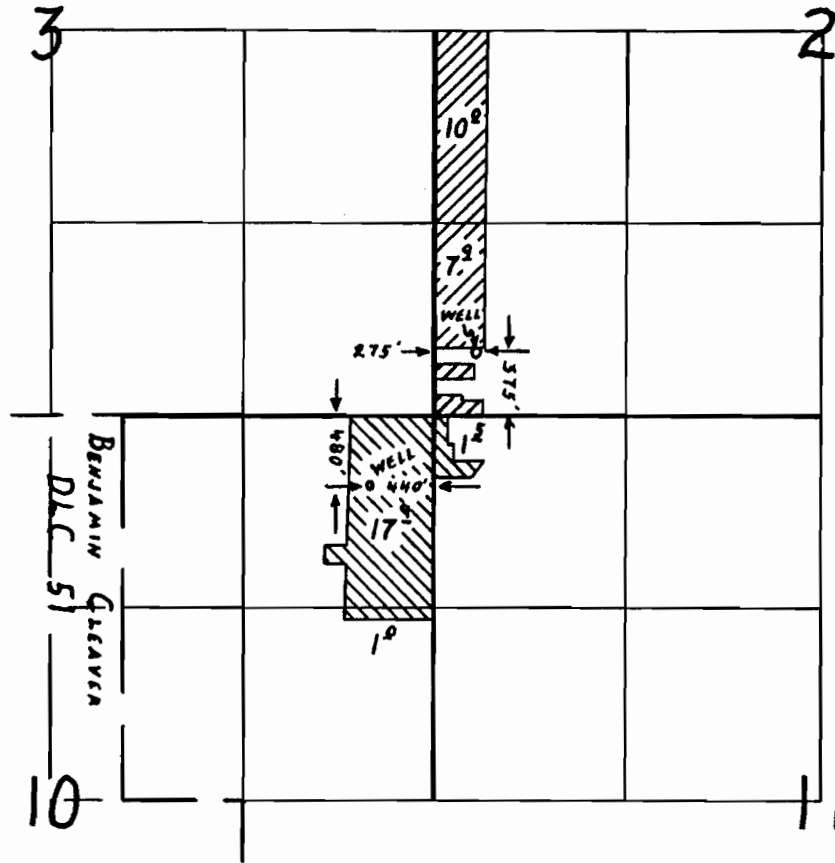

FINAL PROOF SURVEY

UNDER

Application No. G-11510 Permit No. G-10619
G-11527 G-10622

IN NAME OF

ALAN J. KRAEMER

Surveyed JUNE 16, 1992, by R.W.Klassen