


T. 39 S., R. 14 E., W.M.

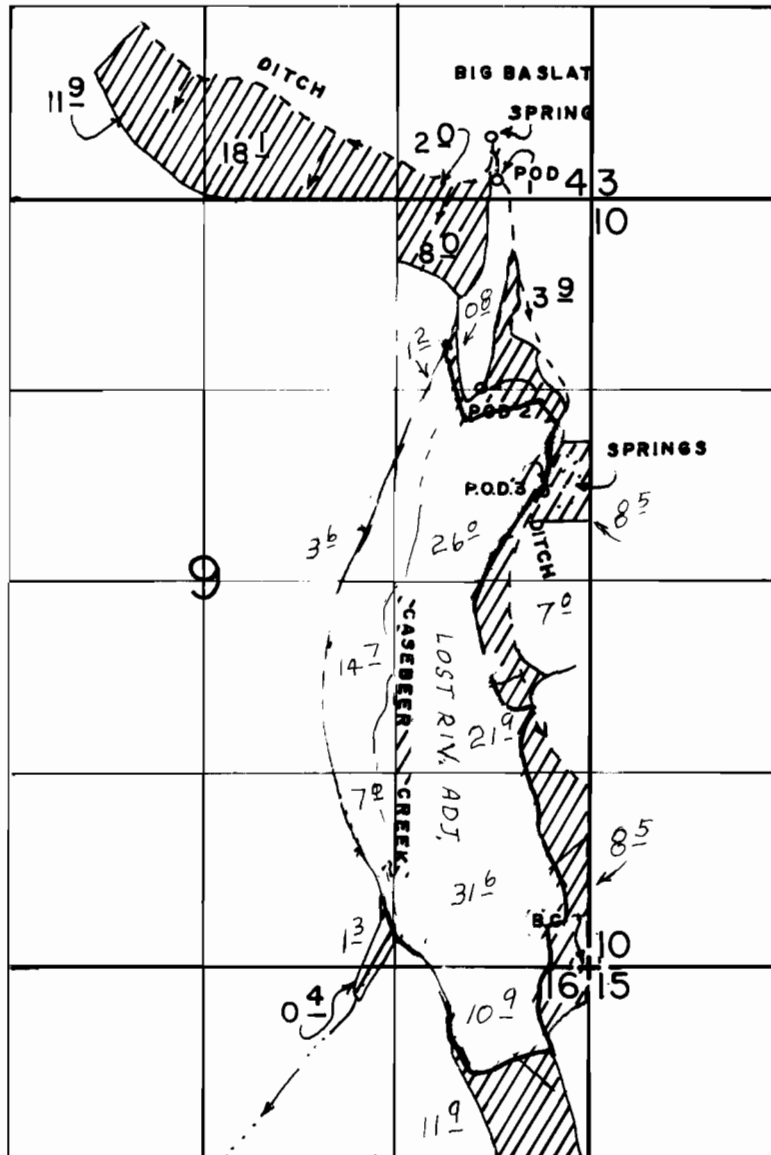

SPRING, LOC: 430' N & 700' W FROM SE COR. OF SEC 4.
P.O.D. 1 LOC: 130' N & 650' W FROM SE COR. OF SEC 4.
P.O.D. 2 LOC: 1300' S & 750' W FROM NE COR. OF SEC 9.
~~P.O.D. 3 LOC: 2000' S & 320' W FROM NE COR. OF SEC 9.~~

FINAL PROOF SURVEY

UNDER

Application No. 63036 Permit No. 47169
IN NAME OF

EDWARD G. LIVINGSTON

Surveyed JULY 7&8, 1992, by B.W.BISHOP

AMENDED 8/31/06 LHN