


T. 38 S., R. 14 E., W.M.

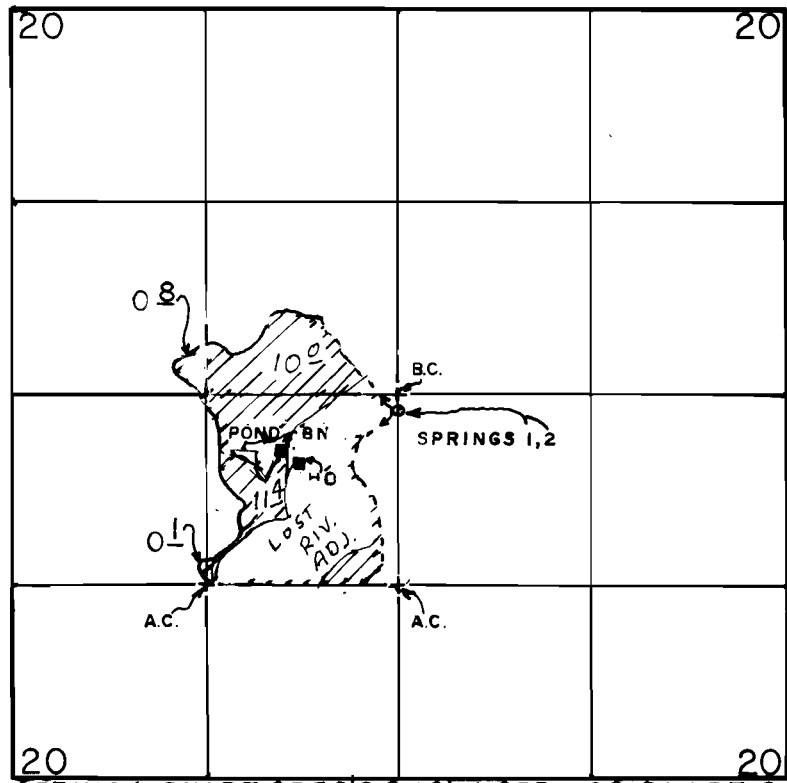

SPRING 1, DIV. PT. 2750' S & 10' W, SPRING 2, DIV. PT. 2730' S & 10' W FROM N1/4 COR. OF SEC 20.

SCALE : 1" = 1320'

FINAL PROOF SURVEY

UNDER

Application No. 63028 Permit No. 47168
IN NAME OF

EDWARD G. LIVINGSTON

Surveyed JULY 7, 1992, by B.W.BISHOP

8/30/06 LAN