


T. 30 S., R. 4 W., W.M.

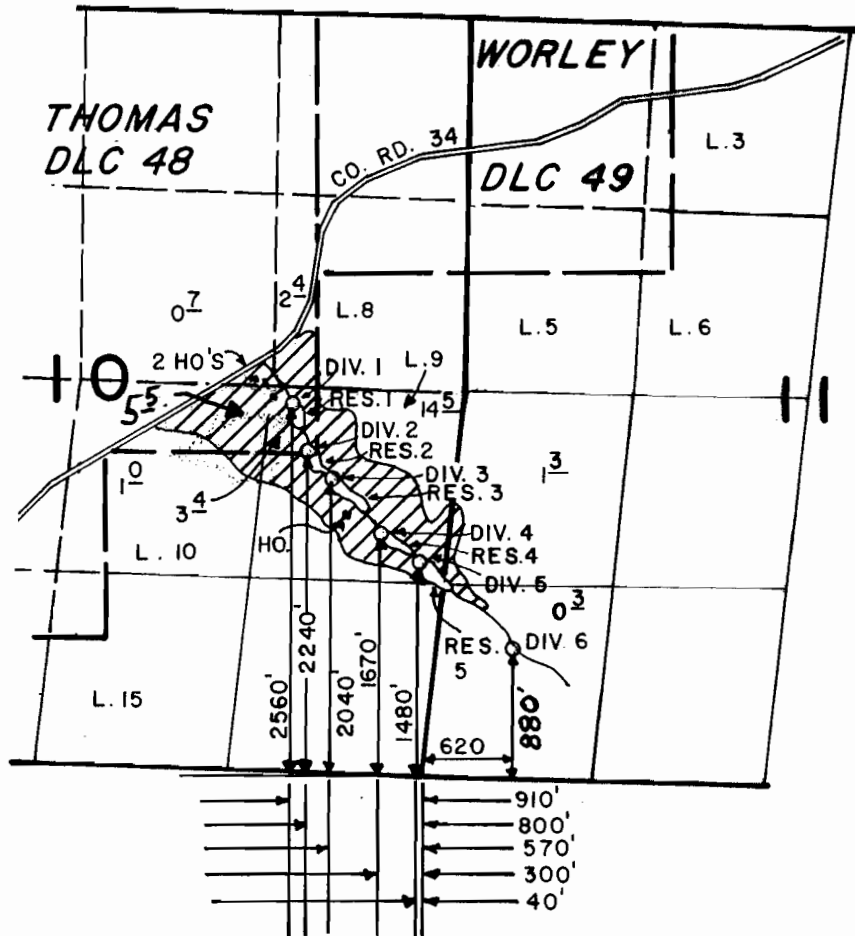

SCALE: 4" = 1 MILE

FINAL PROOF SURVEY UNDER

R-68193 R-10325
Application No. 68125 Permit No. 49184

IN NAME OF

ELMER R. SUTTON

Surveyed JUNE 4, 1986, by J.M. SCHMORDE