


# T. 30 S., R. 4 W., W.M.

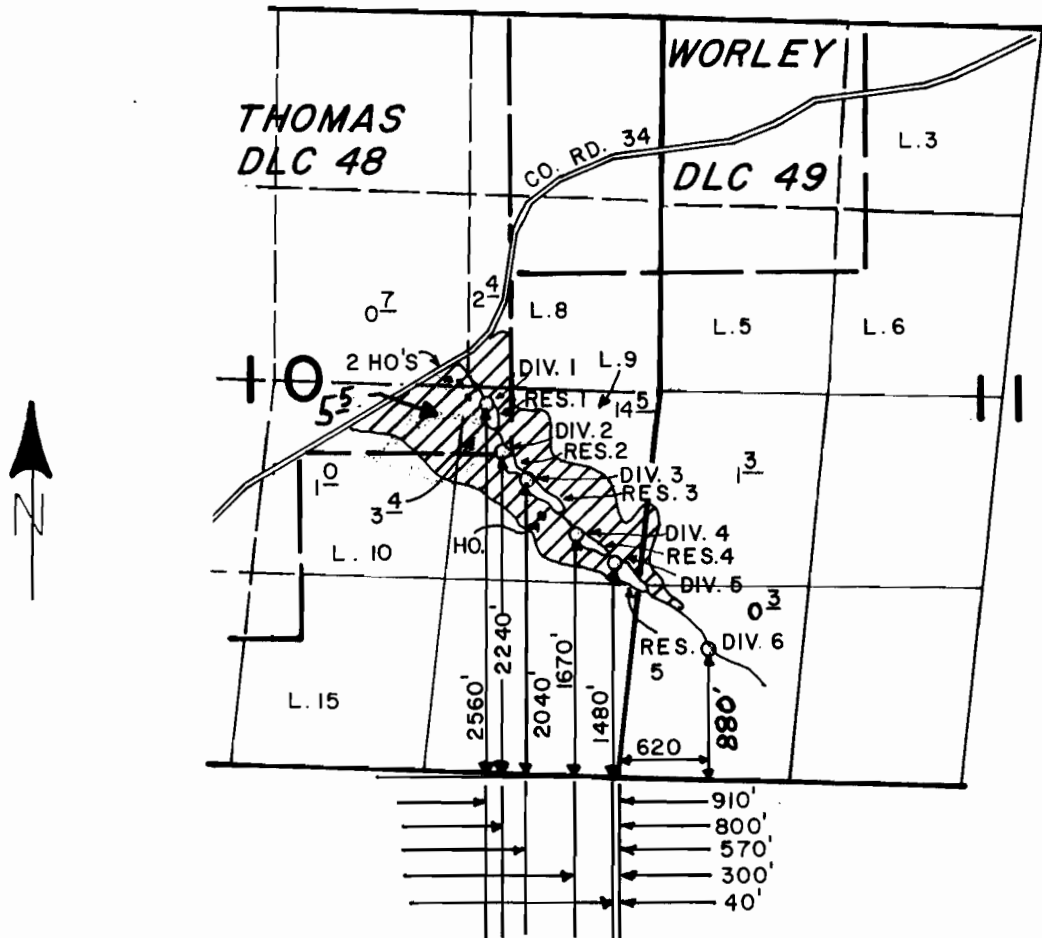

SCALE: 4" = 1 MILE

## FINAL PROOF SURVEY UNDER

R-68193                      R-10325  
 Application No. 68125      Permit No. 49184  
 IN NAME OF

**ELMER R. SUTTON**

Surveyed JUNE 4, 1986, by J.M. SCHMORDE