


T. 26 S., R. 5 W., W.M.

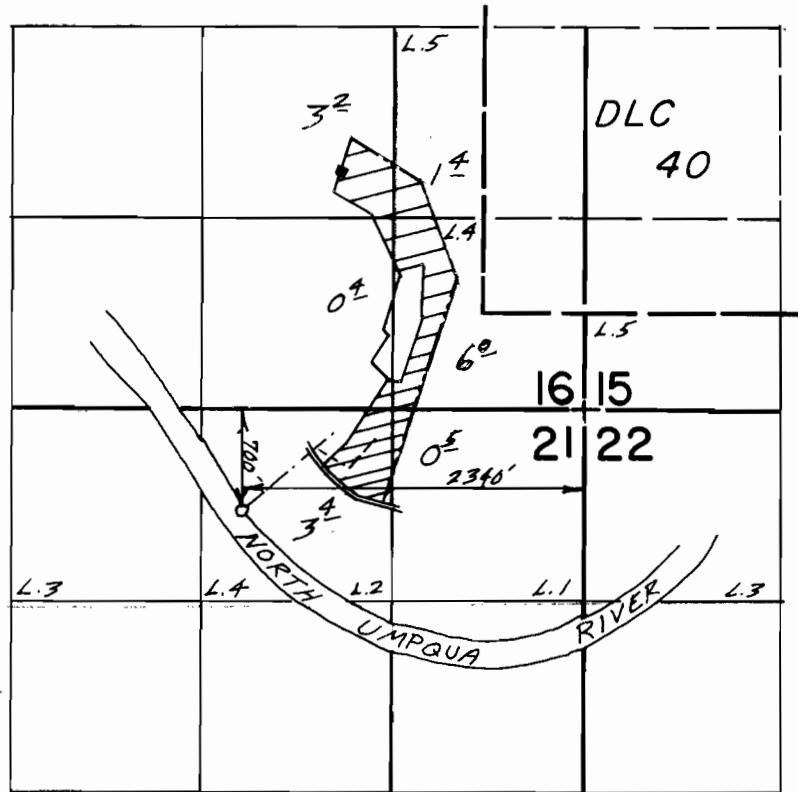

Scale 1" = 1320'

FINAL PROOF SURVEY
UNDER

Application No. 65808 Permit No. 48070...
IN NAME OF

...ROBERT S. or EDNA E. WILMETH.

Surveyed Nov. 30, 1993, by S. JAMES.....