


T. 32 S., R. 5 W., W. M.

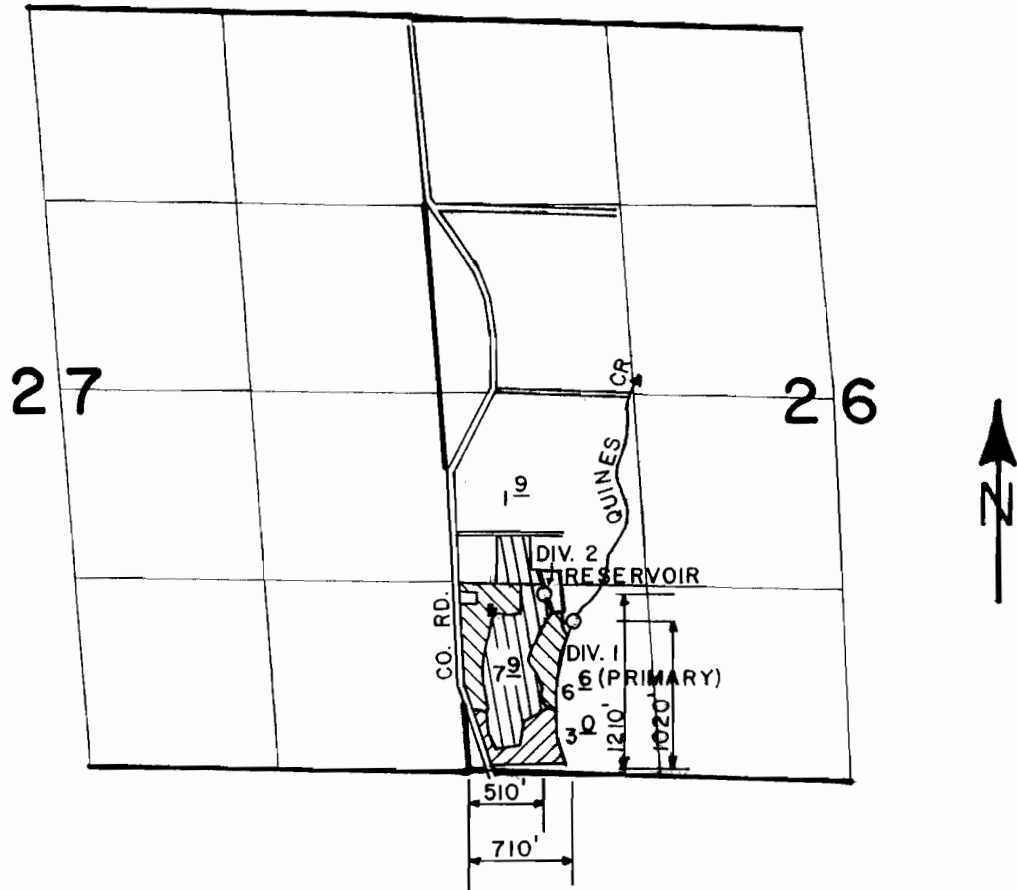

SCALE: 4" = 1 MILE

FINAL PROOF SURVEY
UNDER

T-5395

R-67694



R-10447

Application No. 67695... Permit No. 49241.....

IN NAME OF

WILLIAM E. AND MILDRED TUCKER

Surveyed JULY 7, 1988, by J. M. SCHMORDE.

- T-5395

- PRIMARY

- SUPPLEMENTAL
