


T. 32 S., R. 5 W., W. M.

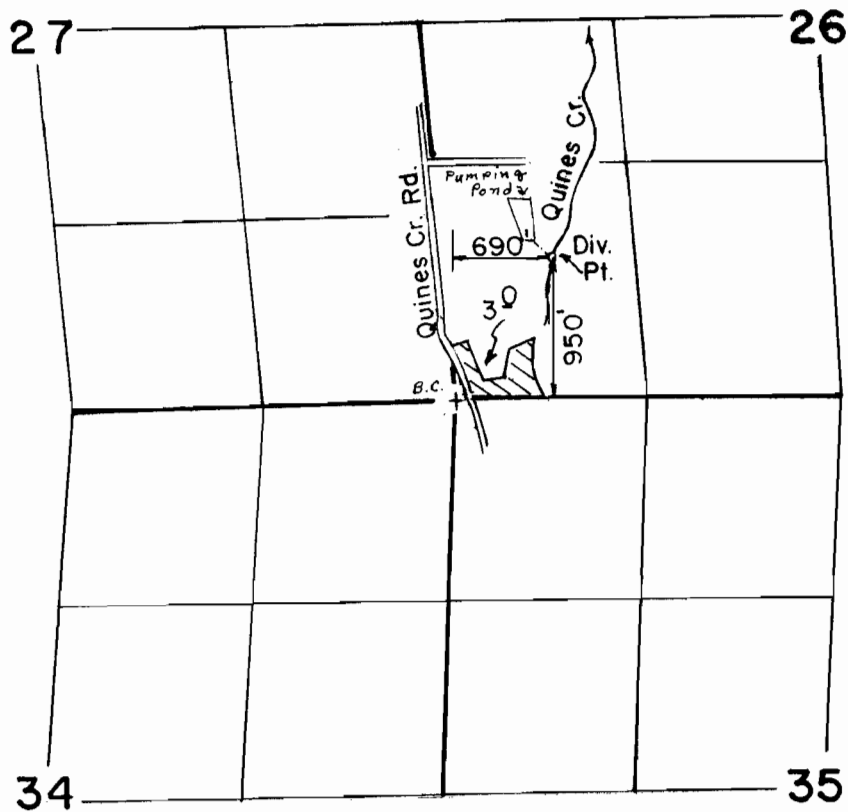

Scale: 1" = 1320'

FINAL PROOF SURVEY UNDER

TRANSFER NO. 5395

Application No. Permit No.
IN NAME OF

WILLIAM E. & MILDRED TUCKER

Surveyed JULY 10, 1990, by B. S. JAMES.....