


T. 1 S., R. 24 E., W.M.

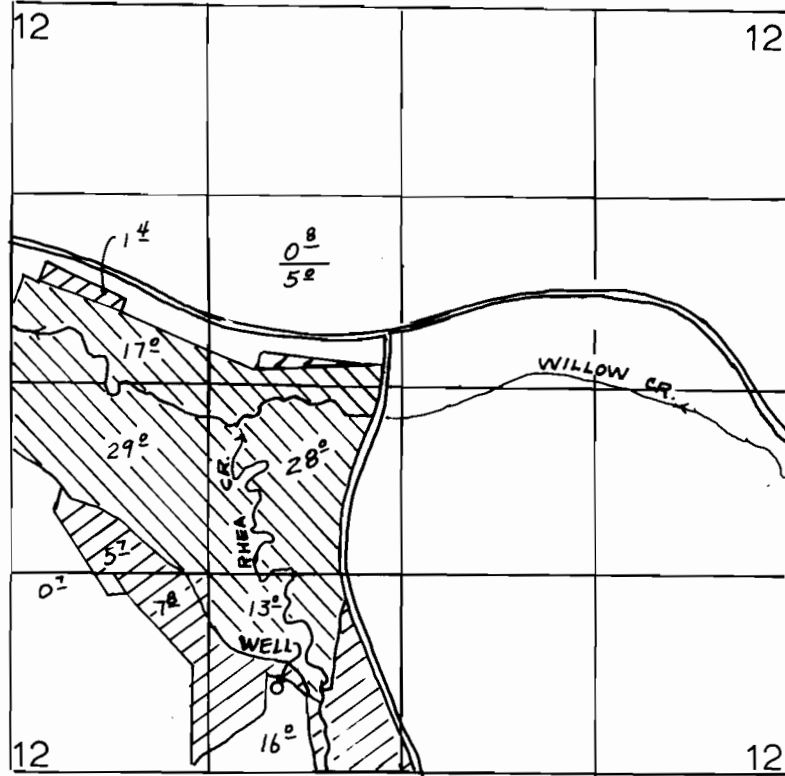

WELL - 600' N. & 1800' E. from SW corner of Section 12.

-  PRIMARY
-  SUPP'L

FINAL PROOF SURVEY

UNDER

Application No. G-9842 Permit No. G-9502

IN NAME OF

LAWRENCE J. AND MARYAN L. McELLIGOTT

Surveyed 4-30, 1992, by J. MILLER