


T. 35 S., R. 1 W., W. M.

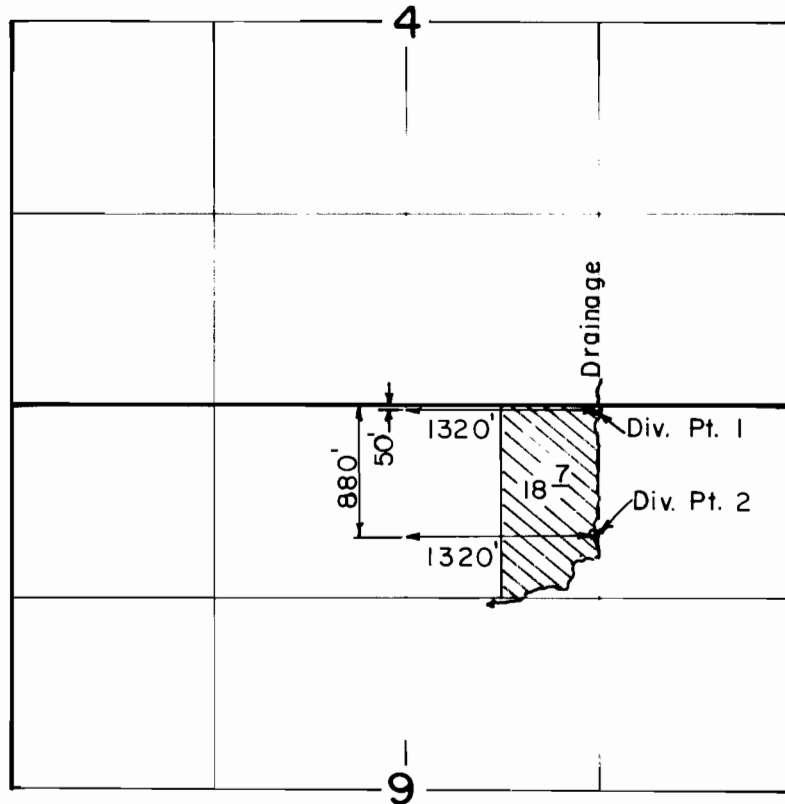

Scale: 1" = 1320'

FINAL PROOF SURVEY
UNDER

Application No. 68759 Permit No. 49963...
IN NAME OF

..... RICK LYNN, SR.

Surveyed JUNE 25 1991., by L.M. JOACHIMS