


T.7 S., R 24 E., W.M.

RECEIVED

JUN 2001  
WATER RESOURCES DEPT.  
SALEM, OREGON

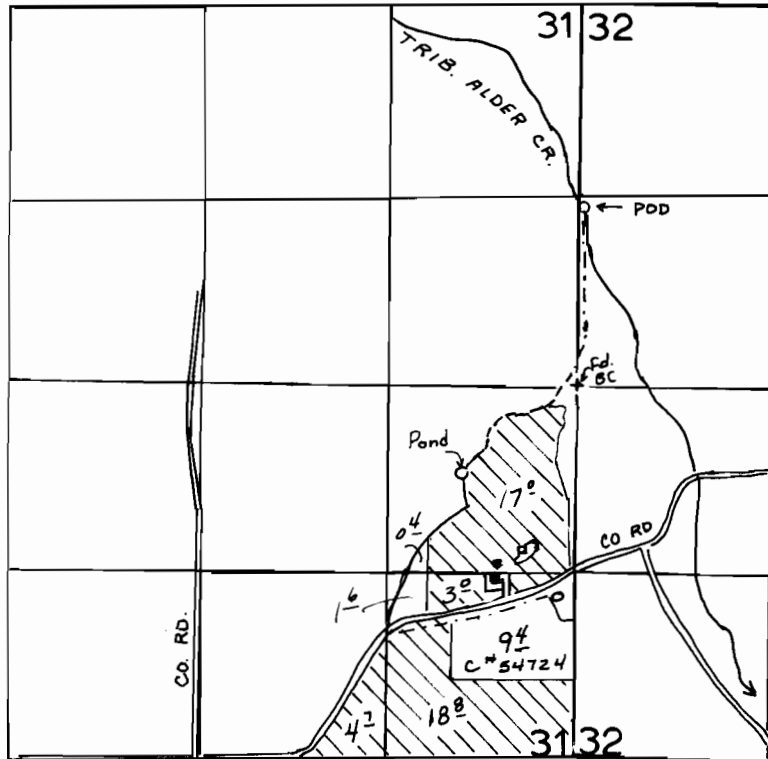

1" = 1320'

POD - 1370'S. & 10'E. FROM THE NE COR. SEC. 31.

## FINAL PROOF SURVEY UNDER

Application No. 58605... Permit No. 44272....  
IN NAME OF

.....DOROTHY.ROBERTA.HOFER.VANDEHEY...

Surveyed ...6-8.... 2000, by J.MILLER.....