


T. 8 S. R. 39 E. W. M.

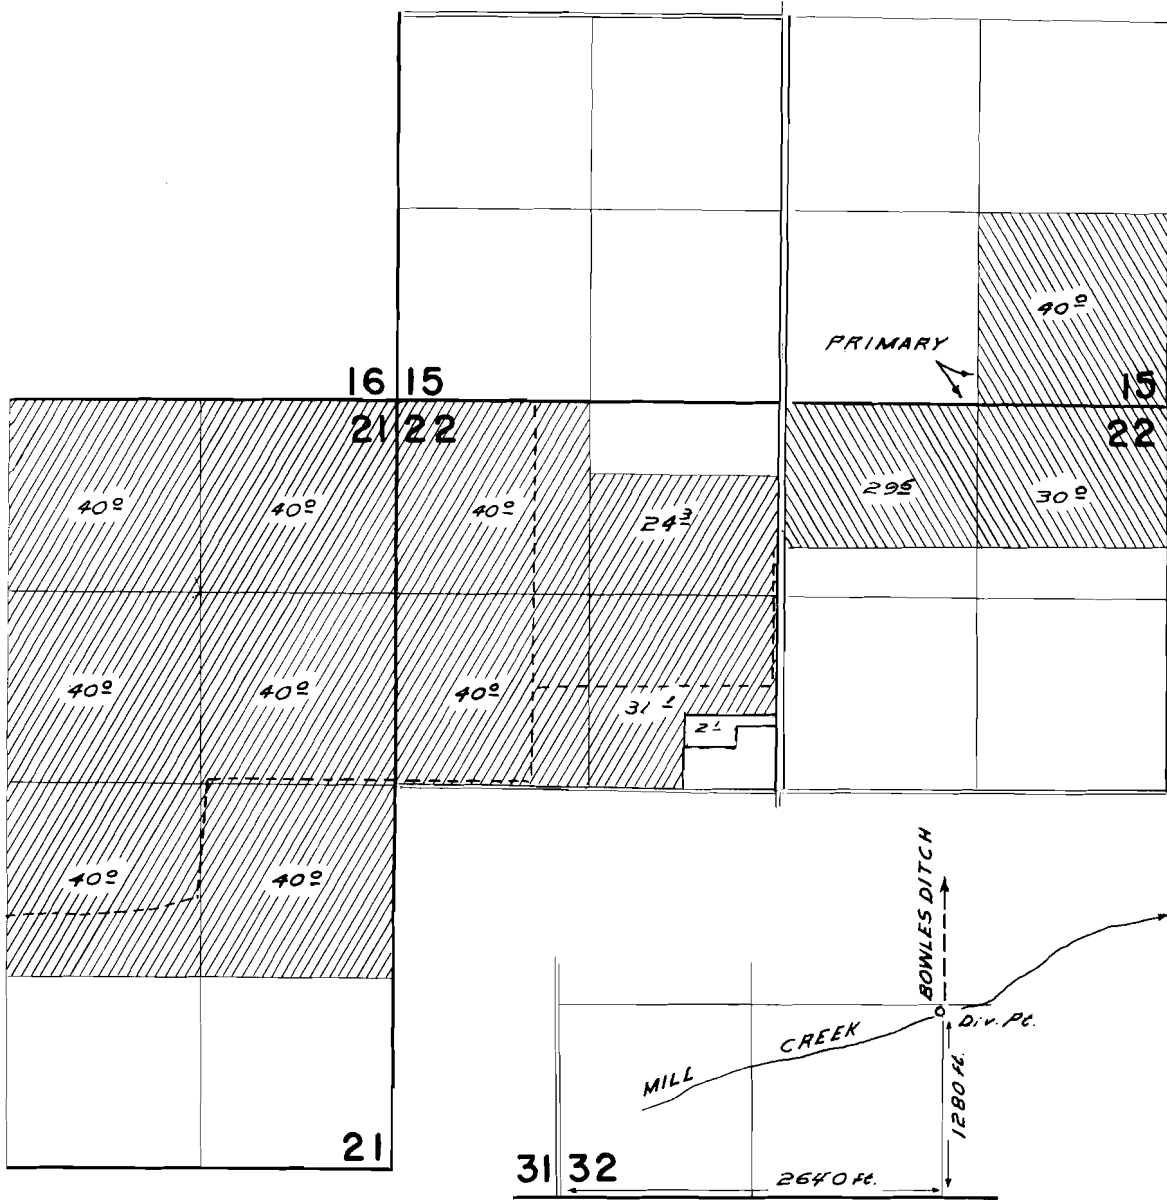

**FINAL PROOF SURVEY**  
UNDER

Application No. 33510 Permit No. 26504  
IN NAME OF

NORBERT L. SIEG

Surveyed NOV. 16, 17 1964, by C. GARDNER