
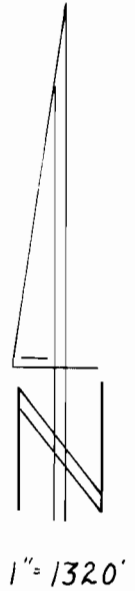


T. 2 N., R. 3 & 4 W., W.M.

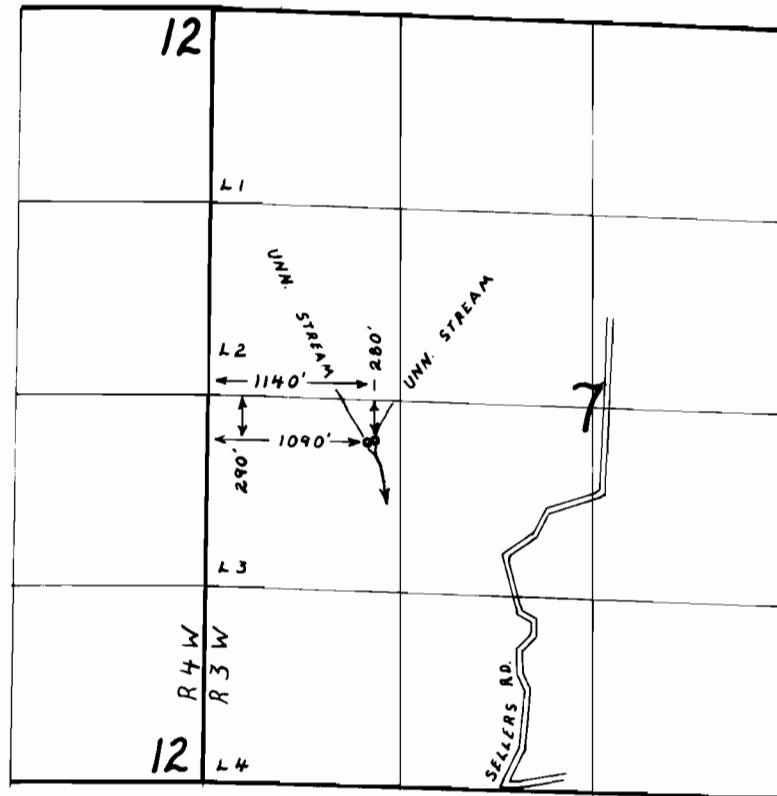

FINAL PROOF SURVEY

UNDER

Application No. 65611 Permit No. 48173

IN NAME OF

CITY OF BANKS

Surveyed JULY 14, 1993, by R.W. Klassen