

T. 9 S., R.25 E., W.M.

APPLICATION MAP FOR

LeRoy & Diana BRITT

RECEIVED
APR 24 1982

WATER RESOURCES DEPT.

RECEIVED

SEP 29 1983


WATER RESOURCES DEPT.
SALEM, OREGON

66964

Application No.

Permit No.

48138

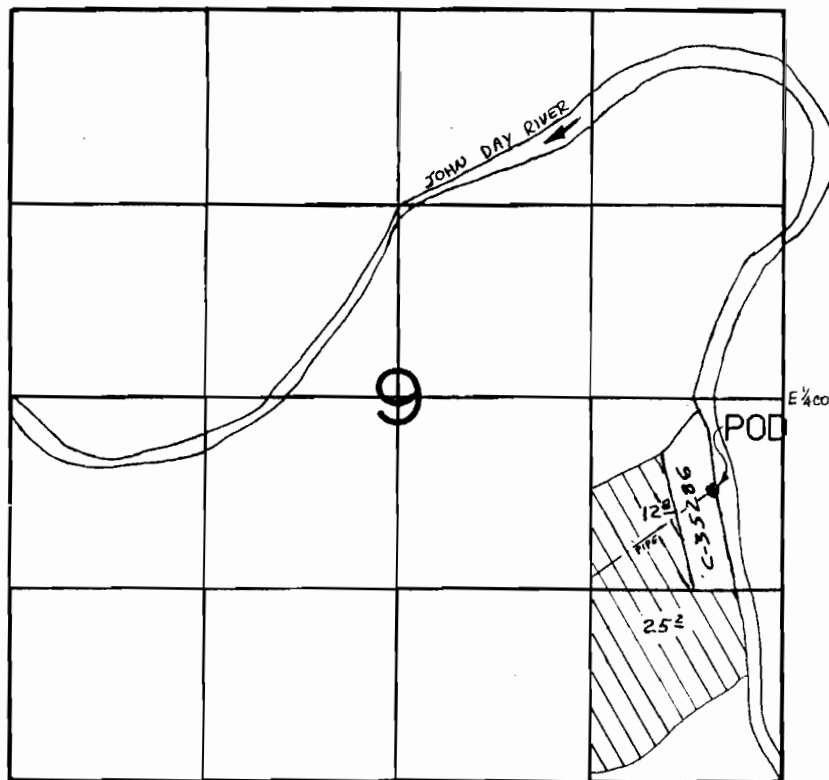

SCALE

4 in = 1 mi

RECEIVED

NOV 14 1983

WATER RESOURCES DEPT.
SALEM, OREGON

POD 600' S & 550' W OF E 1/4 COR SEC. 9

APPROVED

LeRoy Britt

Diana Britt