


T. 8 S., R. 24 E., W.M.

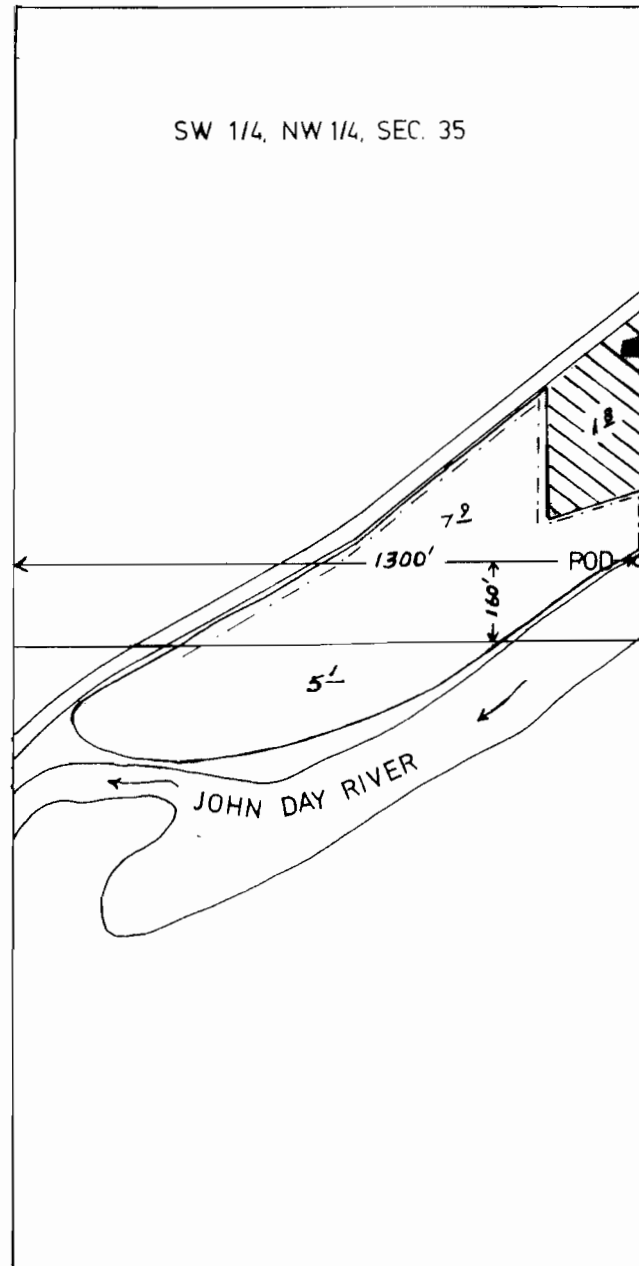

1" = 400'

FINAL PROOF SURVEY UNDER

Application No. 68555 Permit No. 49494
IN NAME OF

JARVIS AND INGEBORG WAGNER

Surveyed 10-31, 1991, by J. MILLER