
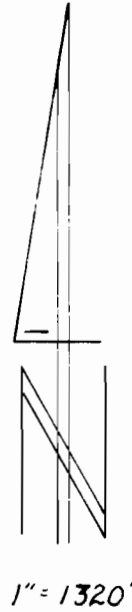


T. 3 N., R. 1 W., W.M.

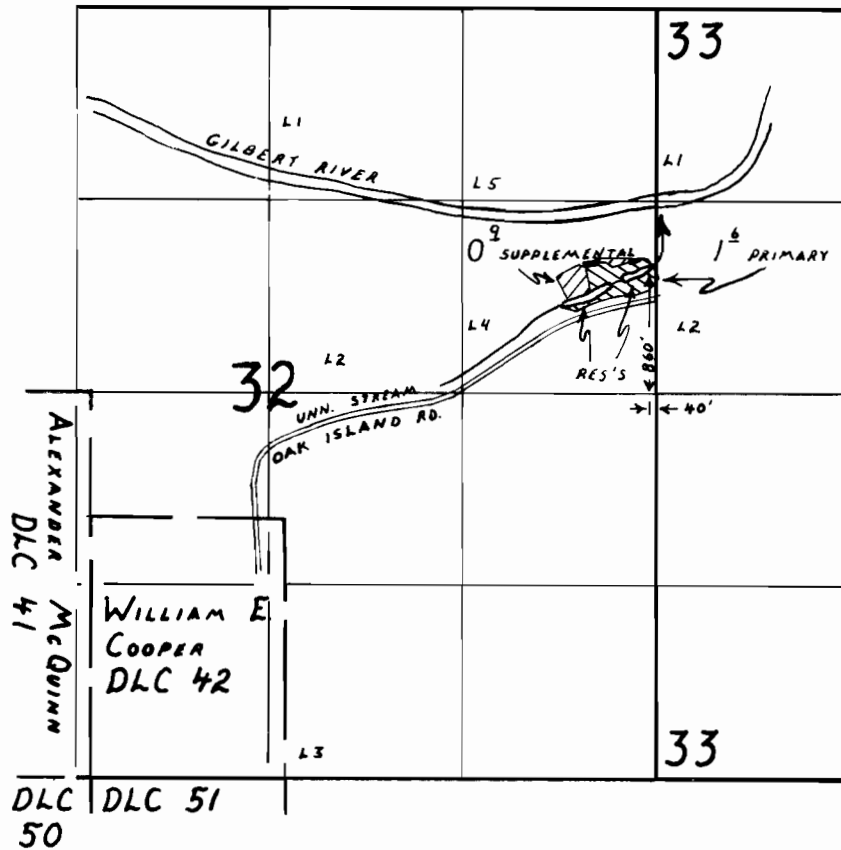

FINAL PROOF SURVEY

UNDER

R-61583

R-8270

Application No. 61453

Permit No. 45743

IN NAME OF

Joseph Lucas Jr.

Surveyed July 7, 1993, by R.W. Klassen