
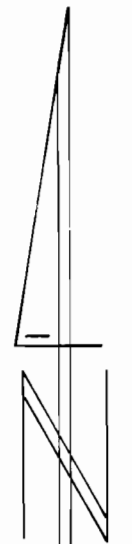


T. 3 N., R. 1 W., W.M.

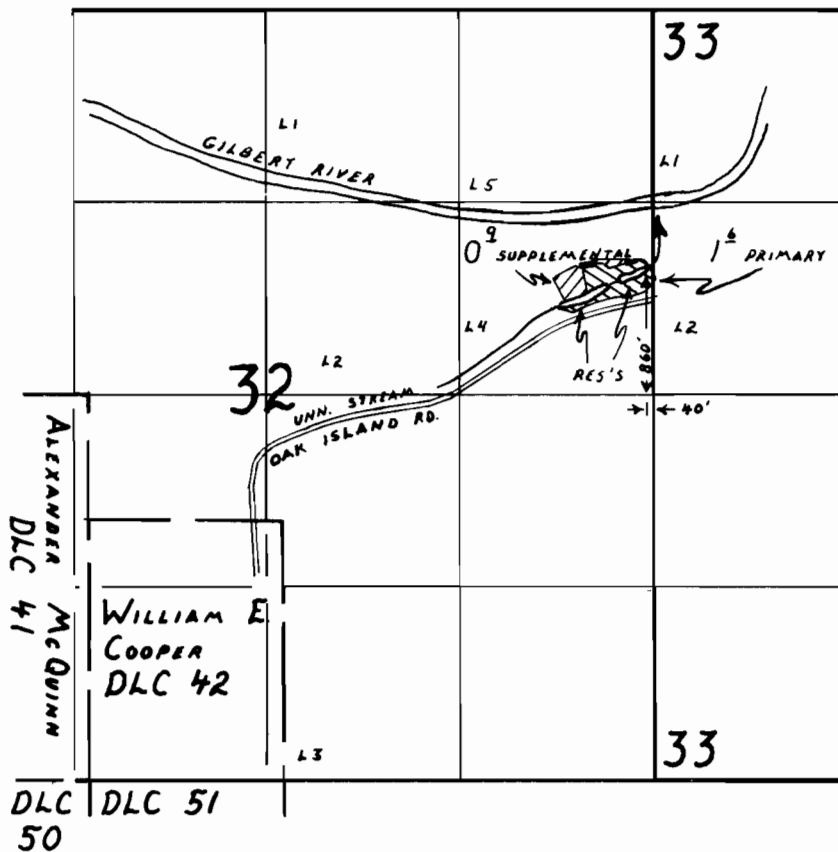

1" = 1320'

FINAL PROOF SURVEY

UNDER

Application No. R-61583 Permit No. R-8270
61453 45743
 IN NAME OF

Joseph Lucas Jr.

Surveyed July 7, 1993, by R.W. Klassen