


# T. 10 S., R. 21 E., W.M.

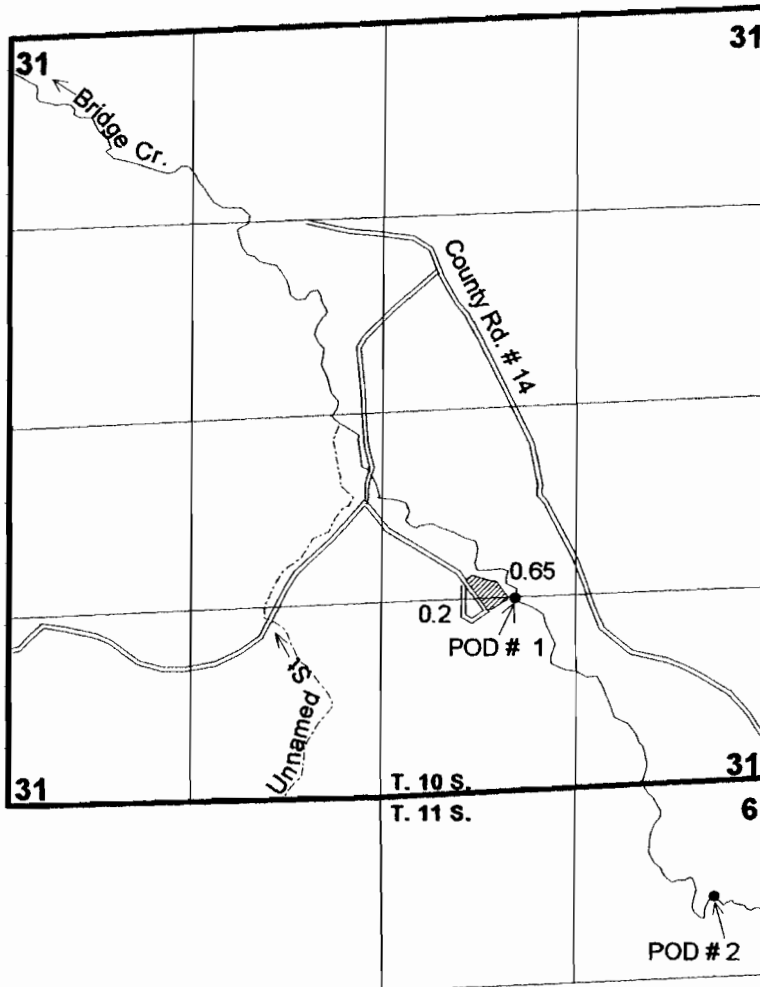

1" = 1320'

POD # 1 - 1320' North and 1768' West from the SE Corner of Section 31.

POD # 2 - 811' South and 372' West from the Northeast Corner of Section 6.

## FINAL PROOF SURVEY UNDER

Application 66013 Permit 49553  
IN THE NAME OF

U. S. D. I. NATIONAL PARK SERVICE

Surveyed 5-17-2000, by J. Miller

RECEIVED

FEB 04 2002

WATER RESOURCES DEPT.  
SALEM, OREGON