
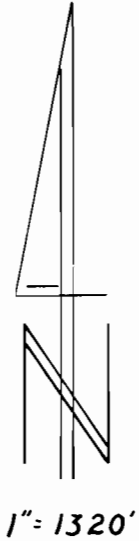


T. 1 S., R. 2 & 3 E., W.M.

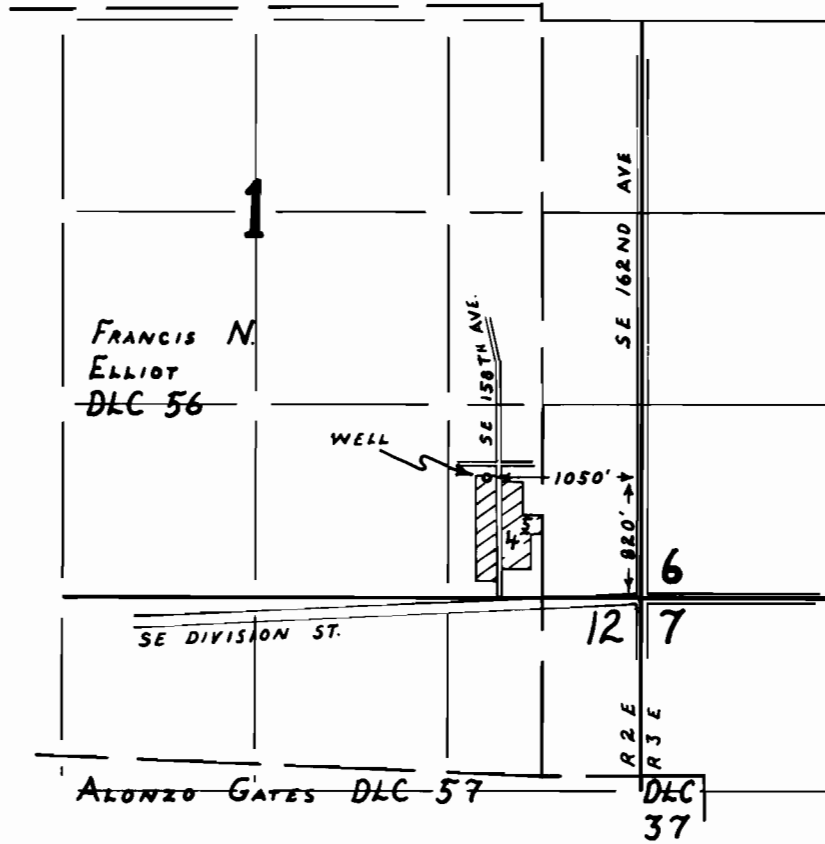

FINAL PROOF SURVEY

UNDER

Application No. G-8514 Permit No. G-8166
IN NAME OF

Lynch Water Cooperative, Inc.

Surveyed August 13, 1993, by R.W. Klassen