


T. 2N., R. 4W., WM.

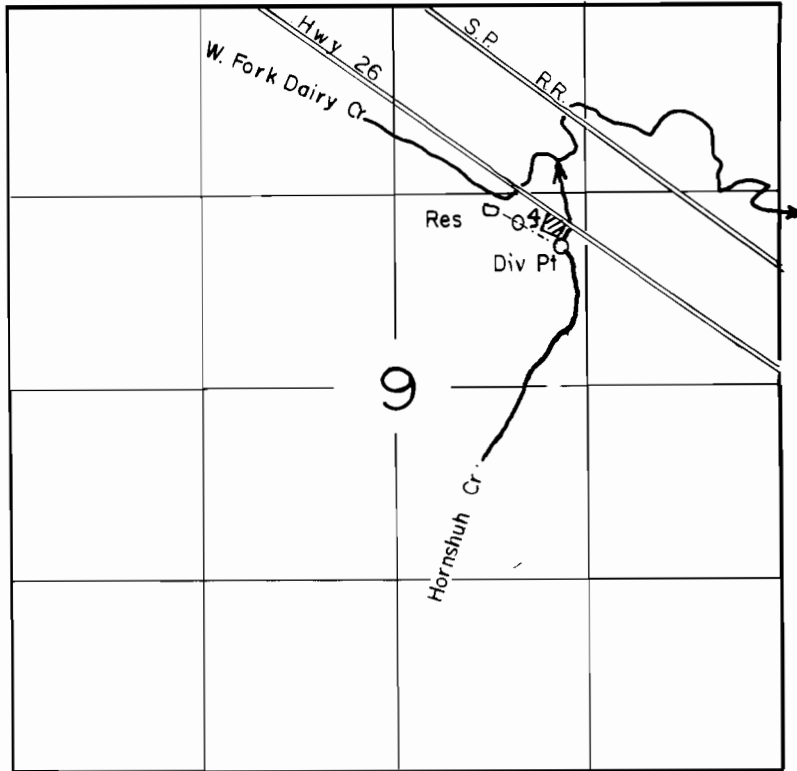

DIV. PT. LOCATED 1650' S & 1500' W FROM NE CORNER SECTION 9

SCALE: 1" = 1320'

FINAL PROOF SURVEY
UNDER

TRANSFER NO. 5513
R- 60566 R- 8257
Application No. 60567... Permit No. 45700.....
IN NAME OF

.....FRED.....HORNSHUH.....

Surveyed JULY 11... 1989., by J.M. WARREN.....