


T. 2 N., R. 1 W., W.M.

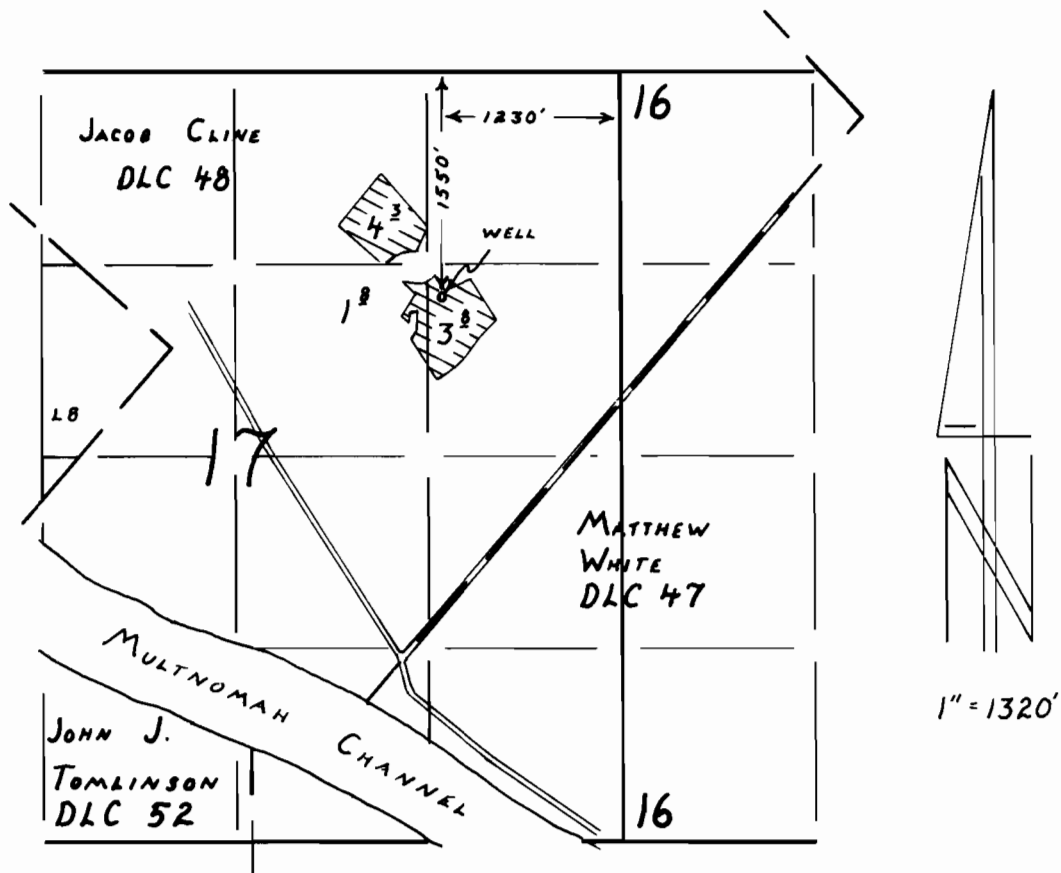

FINAL PROOF SURVEY

UNDER

Application No. G-9574 Permit No. G-9048
IN NAME OF

Robert P. & Anne K. Jones

Surveyed July 8, 1993, by R.W. Klassen