


T. 28 S., R. 7 W., W. M.

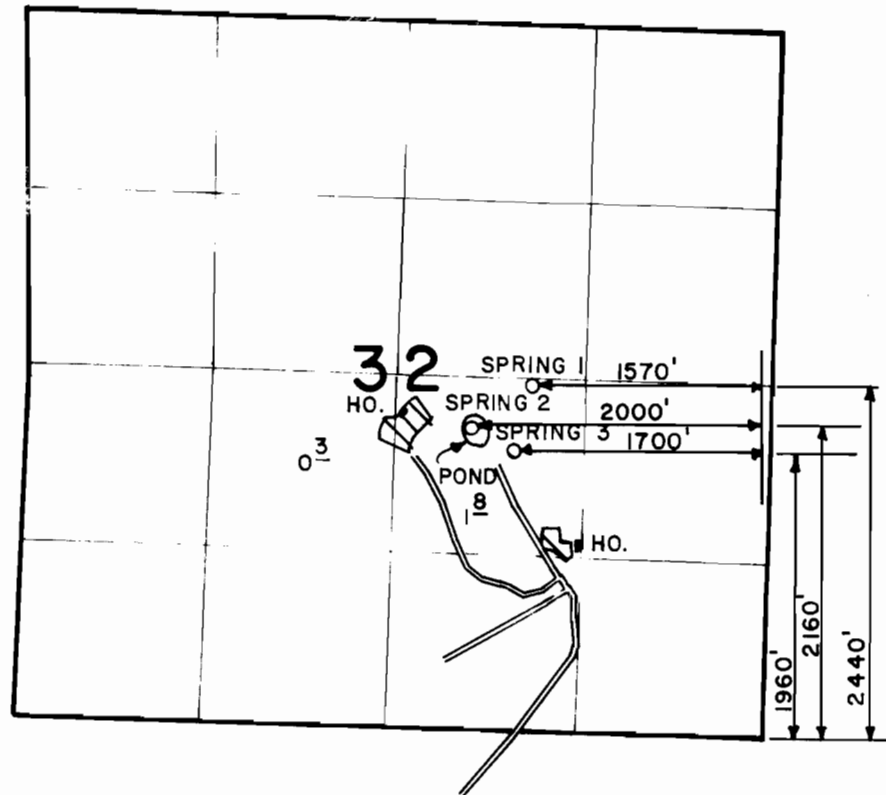

SCALE: 4" = 1 MILE

FINAL PROOF SURVEY

UNDER

Application No. 56924... Permit No. 42818.....
IN NAME OF

JERRY REDENIUS & WALT DICKAUER

Surveyed MAY 14, 1987, by J.M. SCHMORDE.