


SEE MAP  
IS 3 33

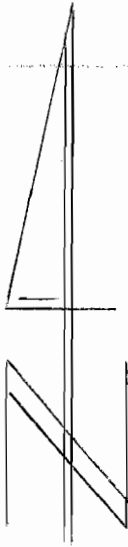

1" = 400'

# FINAL PROOF SURVEY

UNDER

Application No. 61806 Permit No. 45989  
R 61805 .. R 8302

IN NAME OF

ALLEN MUHLY

Surveyed Dec 6 1991, by R W KLASSEN

TAX LOTTED ON  
MAP 2S3 3

