


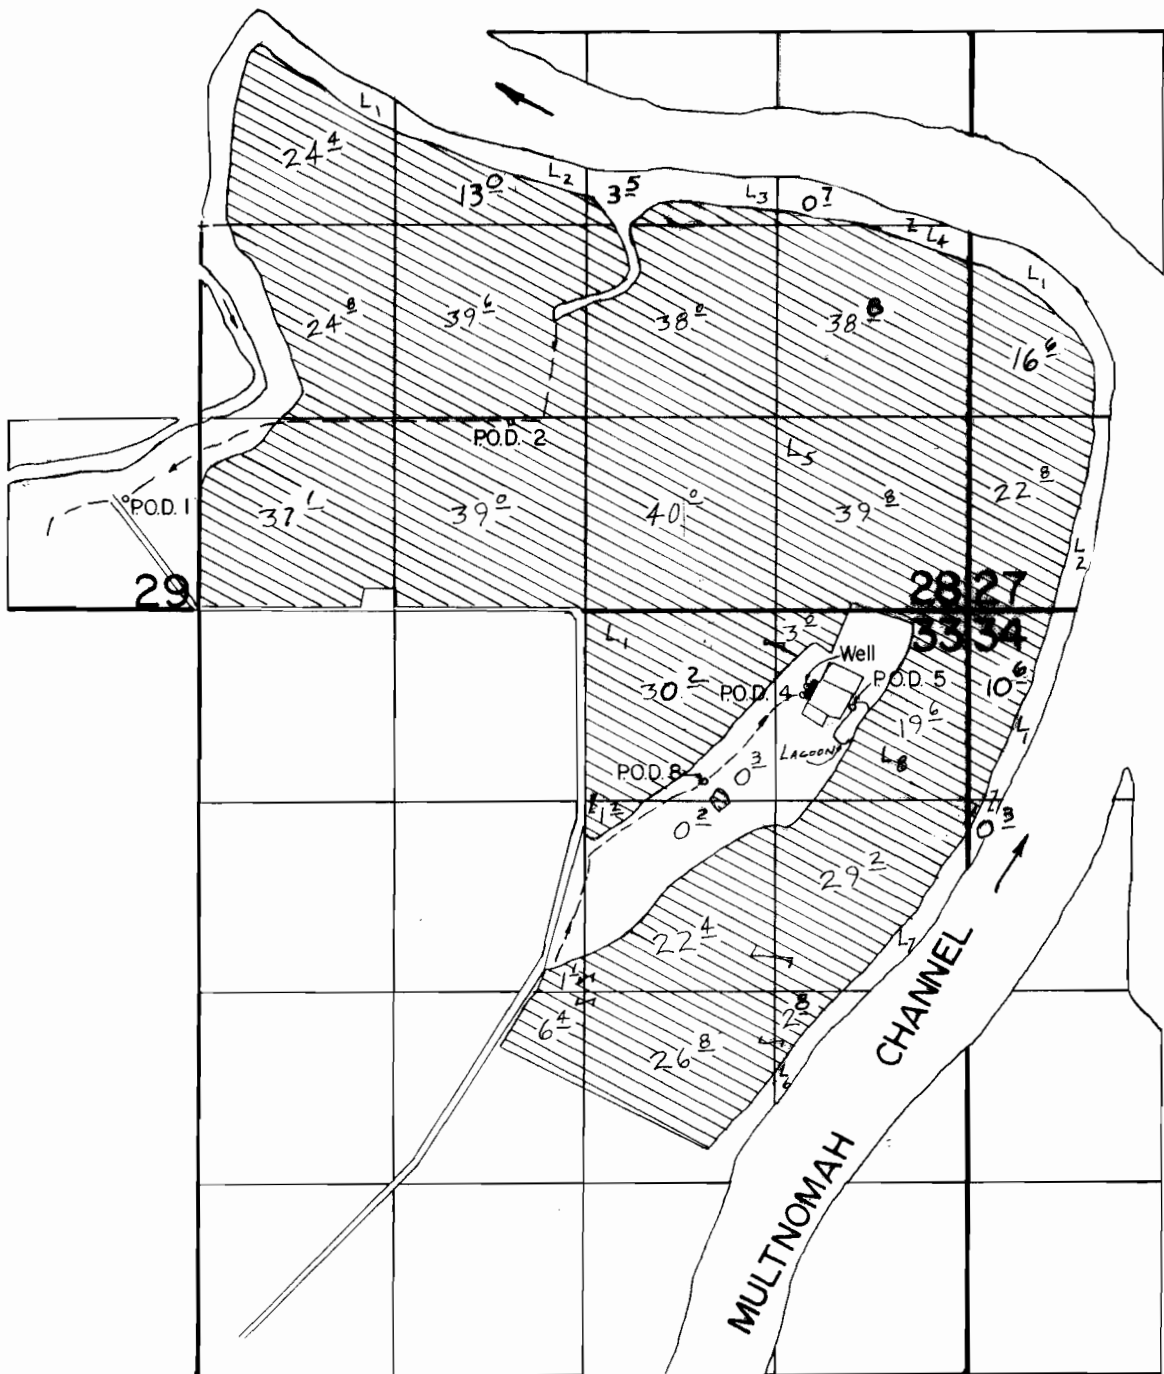

Scale: 1" = 1320'

Well Use : ☐

R- 58956
59254

R-8119
44815

Application G-9377 Permit G-8833

Surveyed June 3, 1986, by T. Warren

41209 300-471