


T. 4N., R. 1W., W. M.

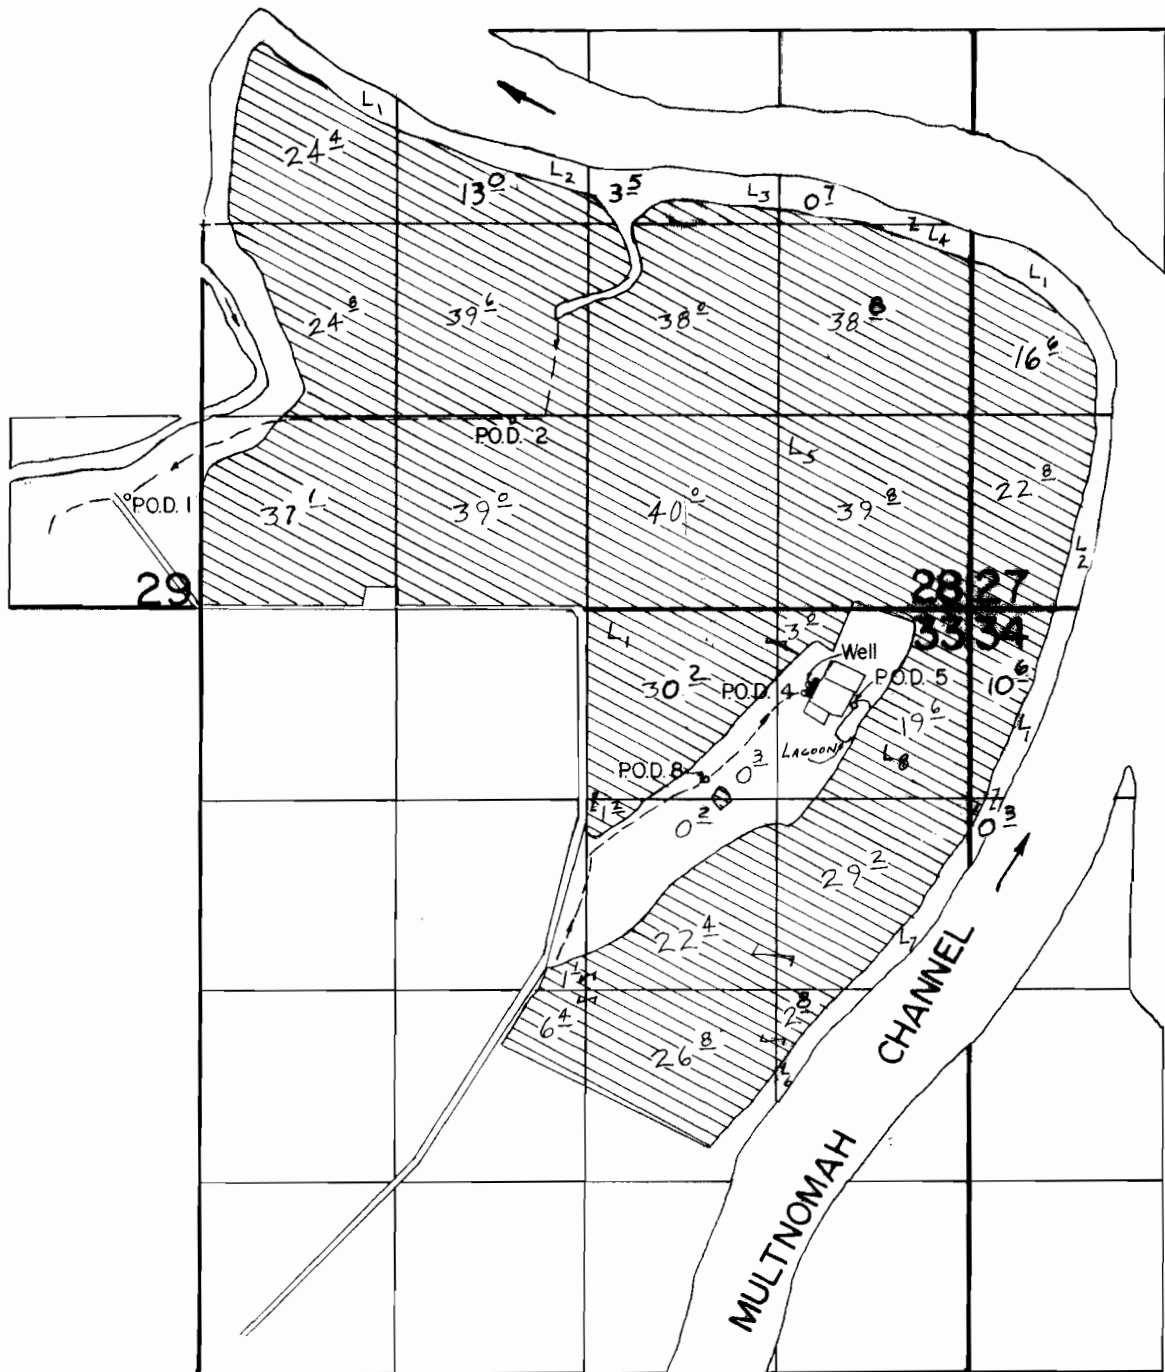

P.O.D. 1 Loc.: 1850' S. & 500' W.
 P.O.D. 2 Loc.: 1350' S. & 2130' E., both from W. 1/4 Cor., Sec. 28.
 P.O.D. 4 Loc.: 590' S. & 1130' W.
 P.O.D. 5 Loc.: 660' S. & 790' W.
 P.O.D. 8 Loc.: 1160' S. & 1810' W.
 Well Loc.: 520' S. & 1100' W., all from NE Cor. Sec. 33.

Scale: 1" = 1320'

Well Use: ■

FINAL PROOF SURVEY under

R-58956
59254

R-8119
44815

Application G-9377 Permit G-8833

Surveyed June 3, 1986, by T. Warren

11709-380-471