


# T. 34S., R. 7E., W.M.

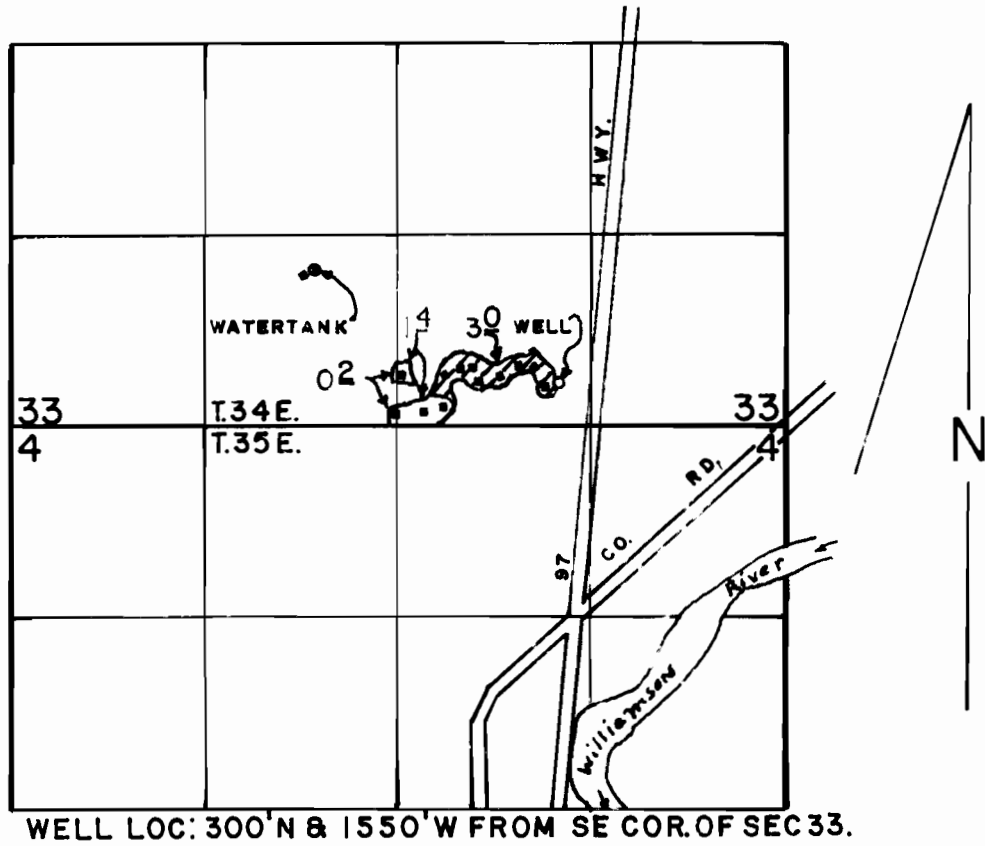

SCALE: 1" = 1320'

## FINAL PROOF SURVEY

UNDER

Application No. G-11410 Permit No. G-10586  
IN NAME OF

UNITED STATES, WINEMA NATIONAL FOREST

Surveyed JUNE 20, 1994, by R.M.SUTTERFIELD