


T.2 N. R.4 W. W.M.

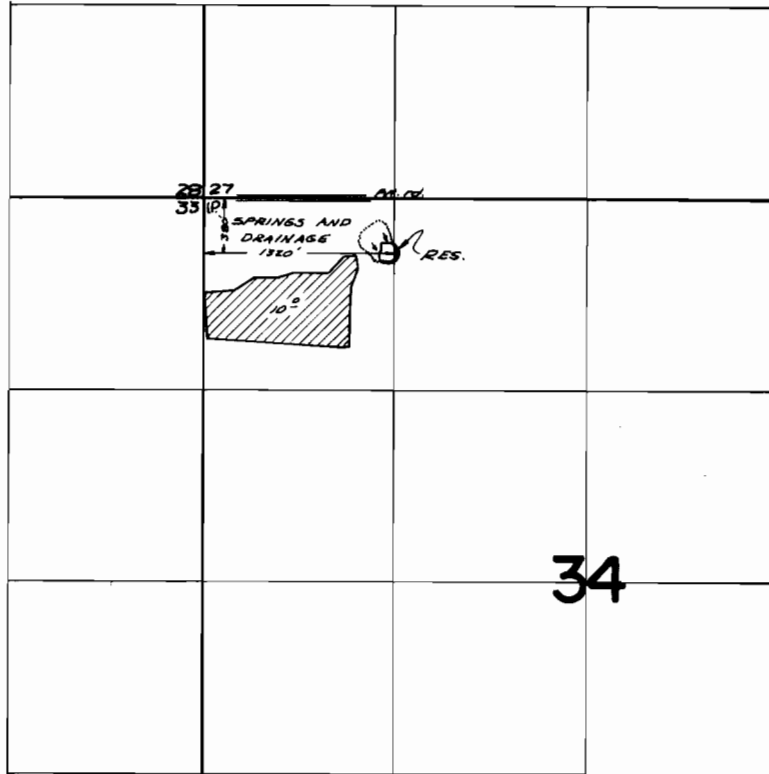

FINAL PROOF SURVEY UNDER

R-39141 *R-3877*
Application No. *39142* Permit No. *29184*
IN NAME OF

ROY TANKERSLY

Surveyed *MAY 10, 1967*, by *V. Garner*